

FILED

Date: 7-11-2018 By: JC

This survey consists of:

Map: _____

Narrative: _____
Corner Rpt: CS65 | 10-19

DOUGLAS COUNTY
SURVEYOR

CORNER REPORT FORM

Section 12 Township 30S Range 3W

Douglas County Date 1-2018

PLSS Number 600600

CORNER DESIGNATION

Sec Cor 2/1
11/12



Condition Report only
Not Found
Renewed
Unrecorded
Surveyed In
Referenced out

Previous Renewals/Surveys, etc:

DC SO 1963 CS 52/138

Monument(s) & Accessories Found: (Condition and Source)

FD DC SO BRASS CAP

20" FIR S45°W 8¹/₂ FT GOOD SCAR

16" FIR South 19¹/₂ FT GOOD SCAR


28" FIR N88°E 14¹/₂ FT GOOD SCAR

18" FIR N86°W 40²/₂ FT GOOD SCAR

8" Cedar S35°E 40²/₂ FT Vis. Scribes BLM 11-15-2017

Monument Detail

Sketch

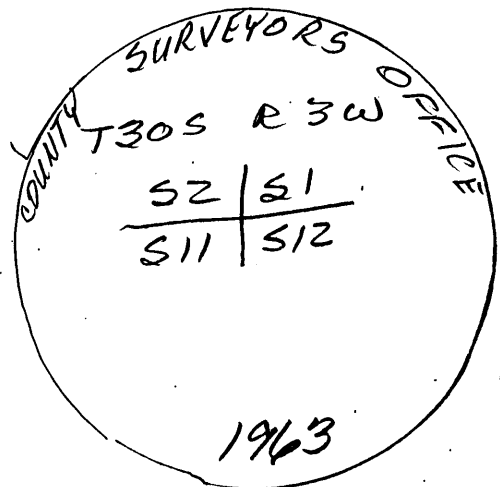

Monument Set (Procedures and Description)

New Accessories

Location & Comments

Compass Declination 15¹/₂°E

Firm/Agency: i.e. Engineering, Inc.



Address: 809 SE Pine St., Roseburg, OR 97470

Party Chief: N. Fromdahl

Notes:

Witness: R. Heichel R. Vincen

Surveyor's Seal

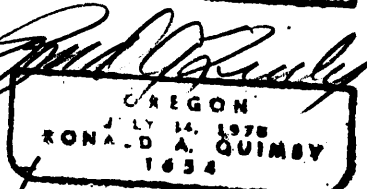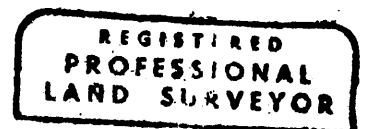

EXP 12-31-18

C.S. File 65/101-19