

FILED

Date: 1-11-2018 By: SC

This survey consists of:

Map: _____

Narrative: _____
Corner Rpt: CS 65/101-21

DOUGLAS COUNTY
SURVEYOR

CORNER REPORT FORM

Section 36 Township 29S Range 3W
Douglas County Date 1-2018
PLSS Number 700200

CORNER DESIGNATION

CC 25
36

- Condition Report only
- Not Found
- Renewed
- Unrecorded
- Surveyed In
- Referenced out

Previous Renewals/Surveys, etc:


GLD Resurvey 1917 Vol 15 P9 4224
DCSD 1963 CS 52/126 EDWARDS 2014 M 172-56

Monument(s) & Accessories Found: (Condition and Source)

2 1/2" DCSD BRASS CAP
32" FIR S65W 26.0 FT GOOD SCAR
34" FIR N45W 23.1 FT GOOD SCAR
Steel Post 2.0 FT South

Monument Detail

Sketch

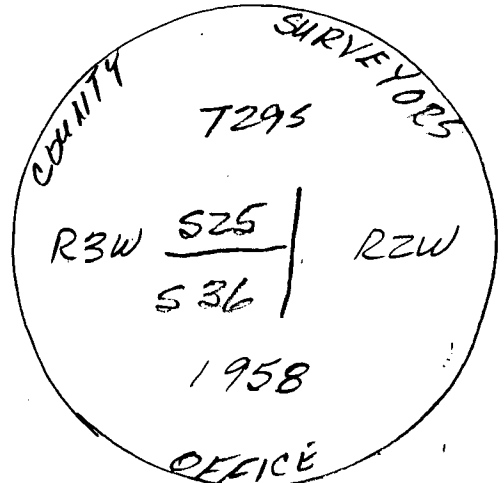

Monument Set (Procedures and Description)

New Accessories

22" FIR S24W 35.5 FT Scribed T29S R3W 536 BT

Surveyor's Seal



Location & Comments

Compass Declination 15 1/2° E
Firm/Agency: i.e. Engineering, Inc.
Address: 809 SE Pine St., Roseburg, OR 97470

Party Chief: N. From Dahl

Notes:

Witness: R. Heichel - R. Vincent

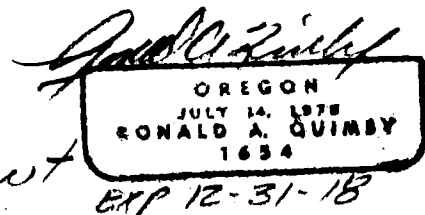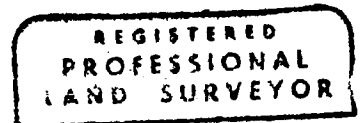

C.S. File 65/101-21