

FILED

Date: 7-17-2018 By: X

This survey consists of:

Map: \_\_\_\_\_

Narrative: \_\_\_\_\_  
Corner Rpt: CS 65/101-24

DOUGLAS COUNTY  
SURVEYOR

CORNER REPORT FORM

Section 30 Township 31S Range 3W  
Douglas County Date 3-2018  
PLSS Number 140200

CORNER DESIGNATION

1/4 COR 30  
31

- Condition Report only
- Not Found
- Renewed
- Unrecorded
- Surveyed In
- Referenced out


Previous Renewals/Surveys, etc:

WCDeroff m 27-14 1946 or 1947  
DC50 1966 CS 62/63 Sweden m 163-35 3/2012  
DC60 1981 CS 41/30

Monument(s) & Accessories Found: (Condition and Source)

5/8" I.R with 1 1/2" Alum Cap  
15" D. FIR STUMP S23°E 18 1/2 FT (Rec S15°W)  
10" MADRONE S65°W 25 1/2 FT VIS Scribes  
45" MADRONE N28°E 14 1/2 FT VIS Scribes (Tree DEAD)  
6" MADRONE N48°W 33 1/2 FT VIS Scribes (Tree DEAD)  
1" Iron Pipe Along Side No Brass Cap

Monument Detail

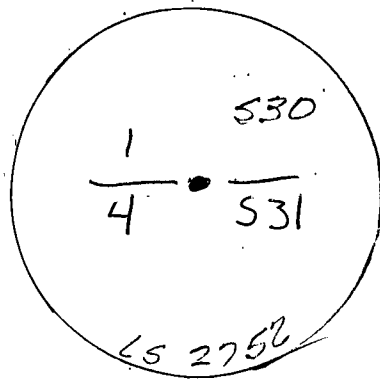

Sketch

Monument Set (Procedures and Description)



New Accessories

10" FIR S 48°E 14 1/2 FT Scribed 1/4 S31 BT  
5" FIR N16°E 24 3/4 FT X chest HIGH  
19" FIR N60°W 22 1/2 FT Scribed 1/4 S30 BT

Location & Comments

Compass Declination 15 1/2° E  
Firm/Agency: i.e. Engineering, Inc.  
Address: 809 SE Pine St., Roseburg, OR 97470  
Party Chief: N. Fromdahl  
Notes: R. Olson  
Witness: R. Vincent - R. Heichel

Surveyor's Seal

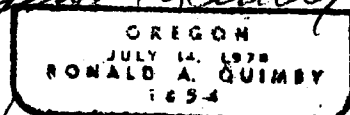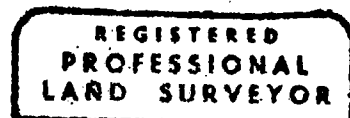

EXP 12-31-18

C.S. File 65/101-24