

FILED

Date: 7-17-2018 By: SC

This survey consists of:

Map: \_\_\_\_\_

Narrative: \_\_\_\_\_

Corner Rpt: CS 65/101-26

DOUGLAS COUNTY  
SURVEYOR

CORNER REPORT FORM

Section 36 Township 21S Range 3W  
Douglas County Date 3-2018  
PLSS Number 640200

CORNER DESIGNATION

1/4 COR 525  
536

- Condition Report only
- Not Found
- Renewed
- Unrecorded
- Surveyed In
- Referenced out


Previous Renewals/Surveys, etc:

DCSO 1966 CS 52163 WILLIAMS PACIFIC CONNECTOR  
ARTMAX M 111-67 5/2015 M 166-40 M 171-2

Monument(s) & Accessories Found: (Condition and Source)

FD 2 1/2 DCSO BRASS CAP  
DOWN 19" Hemlock S 10 1/2° W 82 FT  
DEAD 10" YEW N 19° W 37 1/2 FT VIS. Scribes  
6' T. POST 6' EAST

Monument Detail

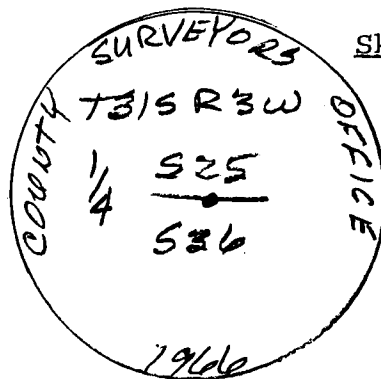

Sketch

Monument Set (Procedures and Description)



New Accessories

10" Hemlock N 53° E 16 1/2 FT	scribed	1/4 525 BT	
10" Hemlock S 72° E 38 1/2 FT	"	1/4 536 BT	
8" W. Fir S 55° E 15 1/2 FT	"	" " "	
12" Hemlock N 12° W 26 1/2 FT	"	1/4 525 BT	Surveyor's Seal

Location & Comments

Compass Declination 15 1/2° E  
Firm/Agency: i.e. Engineering, Inc.  
Address: 809 SE Pine St., Roseburg, OR 97470

Party Chief: N. FROMDAG  
Notes: R. VINCENT  
Witness: R. HEICHEL

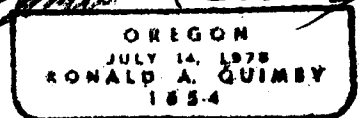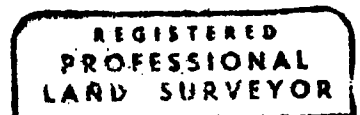

EXP 12-31-18

C.S. File 65/101-26