

FILED

Date: 7-17-2018 By: JC

This survey consists of:

Map: \_\_\_\_\_

Narrative: \_\_\_\_\_

Corner Rpt: CS 65/101-28

DOUGLAS COUNTY  
SURVEYOR

CORNER REPORT FORM

Section 32 Township 21S Range 7W  
Douglas County Date 4-2018  
PLSS Number 3001A0

CORNER DESIGNATION

1/4 COR 532/533

- Condition Report only
- Not Found
- Renewed
- Unrecorded
- Surveyed In
- Referenced out

Previous Renewals/Surveys, etc:

BLM Dependent RESURVEY 1964 VOL 32 PG 13512-3

Monument(s) & Accessories Found: (Condition and Source)

BLM BRASS CAP  
 60" CEDAR SIPOE 22' FT (REG 41' x 27' FT) RESURVED 1/4 532 BT  
 96" CEDAR STUMP (7' HIGH) N89°W 61' FT GOOD SCAR  
 54" CEDAR STUMP (7' HIGH) S41°W 8' FT GOOD SCAR  
 40" Hemlock N42 1/2° E 103' FT GOOD SCAR

Monument Detail

Sketch

1/4  
 532 | 533  
 T21S R7W  
 1964

Monument Set (Procedures and Description)

New Accessories



A 56" OAK N6°W 63' scribed 1/4 532 BT

Surveyor's Seal

Location & Comments

Compass Declination 15 1/2° E  
 Firm/Agency: i.e. Engineering, Inc.  
 Address: 809 SE Pine St., Roseburg, OR 97470

Party Chief: N. Fromdah 1  
 Notes: R. Heichel  
 Witness: R. VINCENT

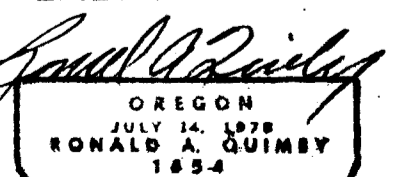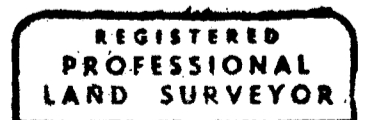

C.S. File EXP 12/31/18  
 CS 65/101-28