

FILED

Date: 7-18-2018 By: JC

This survey consists of:

Map: _____

Narrative: _____

Corner Rpt: CS 65/101-30

CORNER REPORT FORM

Section 25 Township 23S Range 8W
Douglas County Date 4/2018
PLSS Number 640220

DOUGLAS COUNTY
SURVEYOR

CORNER DESIGNATION

CS 1/16 S25

- Condition Report only
- Not Found
- Renewed
- Unrecorded
- Surveyed In
- Referenced out

Previous Renewals/Surveys, etc:


BLM RESURVEY 1985 P 18242

Monument(s) & Accessories Found: (Condition and Source)

BLM BRASS CAP
22" FIR DOWN & ROTTED S45°W 11' FT
18" FIR S29°W (REC N29°W) 24' FT GOOD SCAR

Monument Detail

Sketch

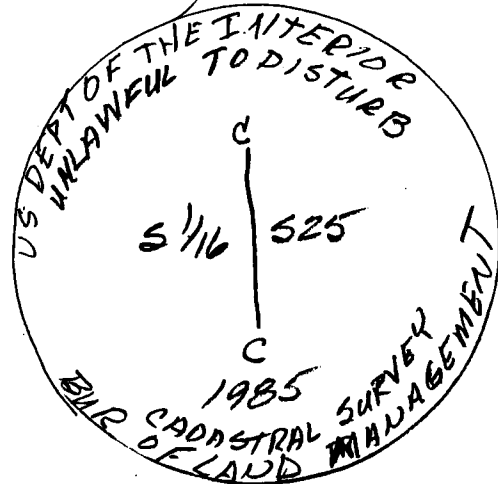

Monument Set (Procedures and Description)

New Accessories

14" FIR N89°W 35' FT Scribed CS 1/16 S25 BT

Location & Comments

Compass Declination 15 1/2° E

Firm/Agency: i.e. Engineering, Inc.

Address: 809 SE Pine St., Roseburg, OR 97470

Party Chief: N. FROMDAHL

Notes: R. VINCENT

Witness: R. Heichel

Surveyor's Seal

REGISTERED
PROFESSIONAL
LAND SURVEYOR

Ronald A. Quimby

OREGON
JULY 14, 1978
RONALD A. QUIMBY
1654

EXP 12-31-18

C.S. File 65/101-30