

FILED

Date: 7-18-2018 By: SC

This survey consists of:

Map: _____

Narrative: _____

Corner Rpt: CS 65/101-32

DOUGLAS COUNTY
SURVEYOR

CORNER REPORT FORM

Section 25 Township 23S Range 8W
Douglas County Date 4/2018
PLSS Number 660220

CORNER DESIGNATION

SE 1/4 S25

- Condition Report only
- Not Found
- Renewed
- Unrecorded
- Surveyed In
- Referenced out

Previous Renewals/Surveys, etc:

NONE

Monument(s) & Accessories Found: (Condition and Source)

Fd 5/8" Iron Rod No Record

Monument Detail

Sketch

Fd 5/8" Iron Rod.
 This ROD fits well with the breakdown of the
 S.E 1/4 of Section 25 by using BLM Notes closure is ± 10'
 USE M 90-38 FOR THE EAST LINE CLOSURE IS ± 2 FT
 BLM EAST LINE 90.01 CH. (2640⁶ FT) M 90-38 2646⁹⁴

Monument Set (Procedures and Description)


New Accessories

12" FIR S20°E 4.6' scribed SE 1/4 S25 BT
 12" FIR N89°W 20' scribed SE 1/4 S25 BT


Surveyor's Seal

Location & Comments

Compass Declination 15 1/2° E
 Firm/Agency: i.e. Engineering, Inc.
 Address: 809 SE Pine St., Roseburg, OR 97470
 Party Chief:
 Notes:
 Witness:

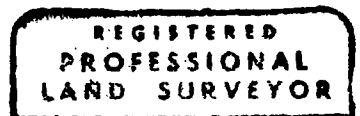

Ronald A. Gimby

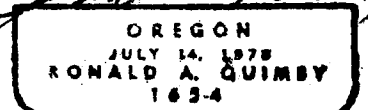

EXP 12-31-18

C.S. File 65/101-32