

FILED

Date: 7-18-2018 By: JC

This survey consists of:

Map: _____

Narrative: _____

Corner Rpt: CS 65/101-35

DOUGLAS COUNTY
SURVEYOR

CORNER REPORT FORM

Section 26 Township 24S Range 2W

Douglas County

Date: 5-2018

PLSS Number

540240

CORNER DESIGNATION

C 1/4

- Condition Report only
- Not Found
- Renewed
- Unrecorded
- Surveyed In
- Referenced out

Previous Renewals/Surveys, etc:

Hosford 1952 M 12-55
Quimby 2013 CS 65/101-23

Monument(s) & Accessories Found: (Condition and Source)

5" I. ROD WITH H LUMI. CAP
 15" D. FIR N43°E 22.1 FT Vis Scribes
 12" D. FIR S 33°E 16.8 FT " " "
 13" D. FIR N40W 23.2 FT " " " Now 6' TALL STUMP?
 19" D. FIR S 37W 15.7 FT " " " " " "

Monument Detail

Sketch



Monument Set (Procedures and Description)

New Accessories

12" Hemlock S88°E 28'-FT scribed C 1/4 S26 BT
 18" FIR N64°E 33'-FT " " " "

Surveyor's Seal

Location & Comments



CORNER IS ON
 EAST EDGE OF
 CLEARCUT UNIT
 APPROX. 700 FEET
 EAST OF SWITCHBACK
 IN GRAVEL ROAD

Compass Declination 15 1/2° E
 Firm/Agency: i.e. Engineering, Inc.
 Address: 809 SE Pine St., Roseburg, OR 97470

Party Chief: N. FROMDAH

Notes:

Witness: R. HEICHEL
 R. VINCENT

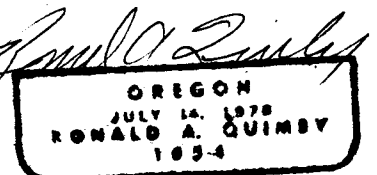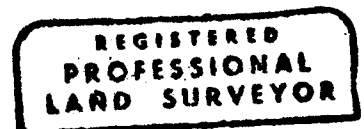

EXP 12-31-18

C.S. File 65/101-35