

FILED

Date: 7-18-2018 By: JC

This survey consists of:

Map: \_\_\_\_\_

Narrative: \_\_\_\_\_

Corner Rpt: C565/101-37

DOUGLAS COUNTY  
SURVEYOR

CORNER REPORT FORM

Section 4 Township 32 S Range 5 W  
Douglas County Date 5-2018  
PLSS Number 340620

CORNER DESIGNATION

C5 1/16

Previous Renewals/Surveys, etc:

M 106-50 Johnstone 1988

Monument(s) & Accessories Found: (Condition and Source)

18" MADRONA N11W 565 FT Fragmentary scribe VIS.  
8" FIR N60E 40.0 FT GOOD SCAR

I. ROD DESTROYED BY RD. CONST.

- Condition Report only
- Not Found
- Renewed
- Unrecorded
- Surveyed In
- Referenced out

Monument Detail

Sketch


Monument Set (Procedures and Description)

A 5/16" I. ROD WITH 2 1/2 ALUM CAP  
AT INTERSECTION OF 2 DIST.


New Accessories

Location & Comments

Compass Declination 15 1/2 E  
Firm/Agency: i.e. Engineering, Inc.  
Address: 809 SE Pine St., Roseburg, OR 97470  
Party Chief: J. LEONARD  
Notes:  
Witness: R. OLSEN

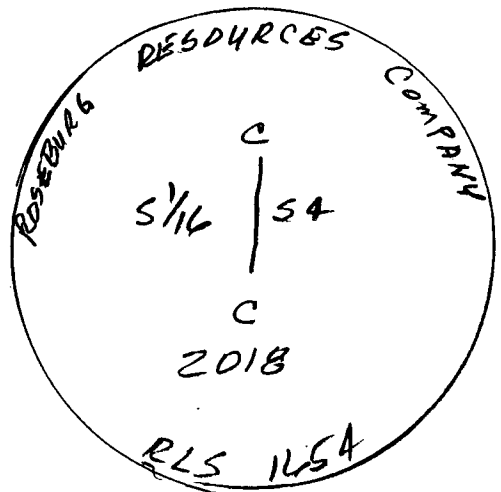

Surveyor's Seal

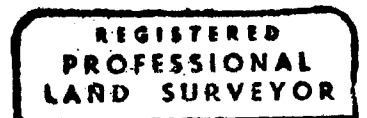

*Ronald A. Quimby*  
 OREGON  
 JULY 14, 1978  
 RONALD A. QUIMBY  
 1854  
 EXP 12-31-18

C.S. File 65/101-37