

FILED

Date: 7-18-2018 By: JC

This survey consists of:

Map: \_\_\_\_\_

Narrative: \_\_\_\_\_


Corner Rpt: CS 65/101-39

**DOUGLAS COUNTY  
SURVEYOR**

CORNER REPORT FORM

Section 8, 9, 16, 17 Township 31S Range 6W  
Douglas County Date 01/18/2018  
PLSS Number 300500

CORNER DESIGNATION

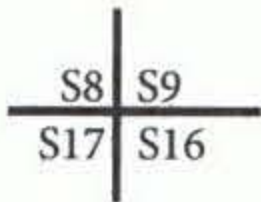

- \_\_\_\_\_ Condition Report only
- \_\_\_\_\_ Not Found
- \_\_\_\_\_ Renewed
- \_\_\_\_\_ Unrecorded
- \_\_\_\_\_ Surveyed In
- \_\_\_\_\_ Referenced out

Previous Renewals/Surveys, etc:

June 1964, Douglas County Surveyors Office Renewal  
Oct. 1980 BLM Resurvey (DCSO records Vol. 45, Pages 17304-04)  
April/June 2008 BLM Corrective Dependent resurvey (DSCO records Vol. 56, Pages 22162-3)

Monument(s) & Accessories Found: (Condition and Source)

Found 2 12" DCSO brass capon 1" iron pipe from which a:  
-43" D fir snag with fragmented scribing visible in partially opened face bears N68°E 20.5'  
-17" Madrone with healed blaze bears S43 1/2°E 48.8'  
-27" sawed D. fir stump topped with tin with fragmented scribing visible in partially healed face bears S68°W 60.7'  
-20" (now 26") Cedar with fragmented scribing visible in partially healed face bears N17°W 55.4'

Monument Detail

Sketch



Monument Set (Procedures and Description)


New Accessories

Surveyor's Seal

Location & Comments

OREGON COORDINATE REFERENCE SYSTEM, COTTAGE GROVE - CANYONVILLE ZONE, NAD 88-(2011), EPOCH 2010 PER GPS OBSERVATION HOLDING NGS CORS STATIONS "RSBG" & "DDSN"  
Lat. N42°53'02.2172"  
Lon. W123°25'36.7033"

Compass Declination 15°  
Firm/Agency: Land Mark Surveying, Inc.  
Address: P.O. Box 13  
Roseburg, OR 97470  
Party Chief: Bartt Heichel  
Notes: \_\_\_\_\_  
Witness: Anthony Welch

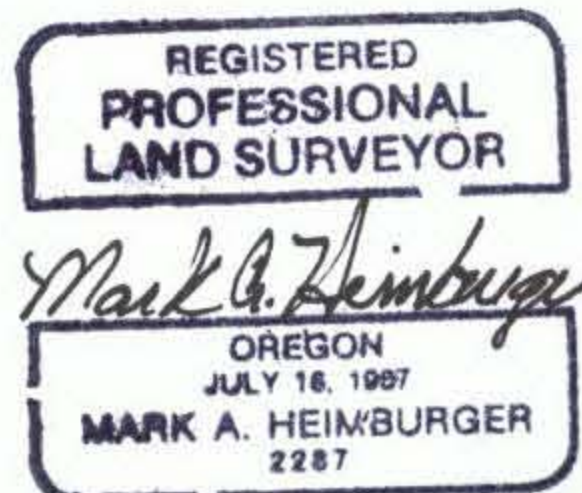

Renews 06/30/19

C.S. File CS/101-39