

FILED

Date: 7-18-2018 By: JC

This survey consists of:

Map: _____

Narrative: _____

Corner Rpt: CS 65/101-45

DOUGLAS COUNTY
SURVEYOR

CORNER REPORT FORM

Section 4 Township 21S Range 10W
Douglas County Date 4-30-18
PLSS Number 340640

CORNER DESIGNATION

Center 1/4

- Condition Report only
- Not Found
- Renewed
- Unrecorded
- Surveyed In
- Referenced out

Previous Renewals/Surveys, etc:

M91-24

Monument(s) & Accessories Found: (Condition and Source)

FND 2 1/2" Brass cap FLUSH Ground Marked Location
By 1/2" REBAR WITH Boundary Tag per C.S. M91-24
C.S. File # 58/140-4

Monument Detail

Original Bearing trees not found.

Sketch


Monument Set (Procedures and Description)

New Accessories

New Bearing trees
 18" Fir Bears S 28° W 15' Tagged, Faced, Red paint nail side center. } tagged
 15" Fir Bears N 84° E 8' " " " " " " } and
 14" Fir STUMP Bears S 56° E 22' TAGGED Nails side center } blazed

Location & Comments

Compass Declination 14°
 Firm/Agency: Stuntzner ENR & Forestry
 Address: Po Box 118
Cave Bay OR 97420
 Party Chief: Danny Dean
 Notes: Ashley Miller
 Witness: _____

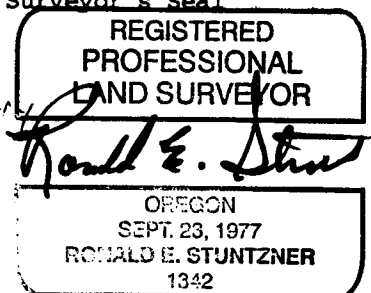

RENEWS:

C.S. File 65/101-45