

# OREGON CORNER RESTORATION FORM

SECTION 6

TOWNSHIP 23 S.

RANGE 5W

COUNTY DOUGLAS

DATE 6/8/2017

TRACT J23-5-6 / BECKLEY

**CORNER DESIGNATION:**

T 23 S R 5 W

W1/16 — S6  
          ○  
          S7

POINT IDENTIFIER 120600

- CONDITION REPORT ONLY
- NOT FOUND
- RENEWED
- UNRECORDED
- SURVEYED IN
- REFERENCED OUT

**PREVIOUS RENEWALS/SURVEYS, ETC:**

1994 BAKER MAP M118-43, 1952 HAYDON MAP CS 41/65


**ACCESSORIES FOUND: (CONDITION AND SOURCE)**

5/8" REBAR BEARS S89°29'42"E 46.93 FT. (RECORD S89°18'23"E 47.12 FT.)

8" MADRONE BEARS S66 1/2°E 9.95 FT. (RECORD S69°E 9.6 FT.) HEALED FACE AND TAG

42" CEDAR STUMP BT FOR REBAR BEARS S39°W 53.6 FT. (RECORD S42°W 54.6 FT.)

**MONUMENT DETAIL:**

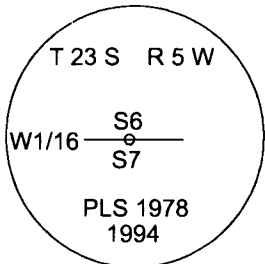

**BASIS OF BEARING**

[S89°36'E 1228.37']


<S89°36'E 1220.09'>

(N89°27'50"E 1219.37')

N89°27'50"E 1219.36'

**SKETCH:**

(NOT TO SCALE)

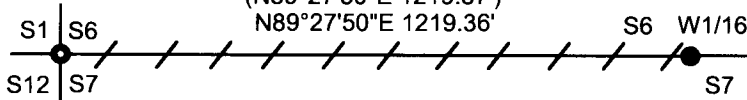

**LEGEND:**

- LINES BLAZED, PAINTED, AND TAGGED
- FND 1994 BAKER BRASS CAP PER M 118-43
- FND 1943 GLO BRASS CAP
- ( ) RECORD FROM MAP M 118-43
- < > RECORD FROM MAP CS 41/65
- [ ] RECORD FROM 1943 GLO DEPENDANT RESURVEY

**MONUMENT:**

FOUND 1994 BAKER 2" IRON PIPE WITH 2" BRASS CAP PER M118-43

**NEW ACCESSORIES:**

16" DOUGLAS FIR BEARS N57°W 22.5 FT. WE SCRIBE W1/16 S6 BT AND TAG TREE

**LOCATION & COMMENTS:**

WE RAN A RANDOM CLOSED LOOP TRAVERSE BEGINNING AT THE W 1/16 CORNER BETWEEN SECTIONS 6 & 7, TRAVERSING WESTERLY TO THE SOUTHWEST CORNER OF SECTION 6, A 1943 GLO BCIP. WE THEN BLAZED, PAINTED, FLAGGED, AND TAGGED TRUE LINE. CORNER LIES ON STEEP WEST FACING SLOPE APPROX. 200 FEET WEST OF RIDGETOP.

**BEARING BASIS:** ASSUMED FROM BAKER MAP

M118-43 W1/16 COR. TO SWSC

**FIRM/AGENCY:** LONE ROCK TIMBER MANAGEMENT CO.

**ADDRESS:** P.O. BOX 1127

ROSEBURG, OR 97470

**PARTY CHIEF:** KEN W. HOFFINE

**NOTES:** GARY ANGIOLET

**WITNESS:** IGNACIO ROMAN

FILED

Date: 7/24/2018 By: JC

This survey consists of:

Map: \_\_\_\_\_

Remarks: \_\_\_\_\_

Corner Rpt. CS 65/101-50

**DOUGLAS COUNTY SURVEYOR**

REGISTERED  
PROFESSIONAL  
LAND SURVEYOR

*Ken W Hoffine*

OREGON  
JULY 16, 1987  
**KEN W. HOFFINE**  
PLS 2291

C.S. FILE 65/101-50

EXPIRES 6-30-19