

FILED

Date: 7/24/2018 By: SC

This survey consists of:

Map: _____

Narrative: _____

Corner Rpt: CS 65/101-55

DOUGLAS COUNTY
SURVEYOR

CORNER REPORT FORM

Section 11 Township 32S Range SW
Douglas County Date: 7-2018
PLSS Number 540540

CORNER DESIGNATION

C 1/4 S11 T2N R2E 21694

- Condition Report only
- Not Found
- Renewed
- Unrecorded
- Surveyed In
- Referenced out


Previous Renewals/Surveys, etc:

BLM 2007
Wytcherley 2007 m 153-28

Monument(s) & Accessories Found: (Condition and Source)

BLM BRASS CAP
14" PINE N80°W 24³ FT GOOD SCAR
10" PINE S27¹/₂°W 28⁴ FT GOOD SCAR

Monument Detail

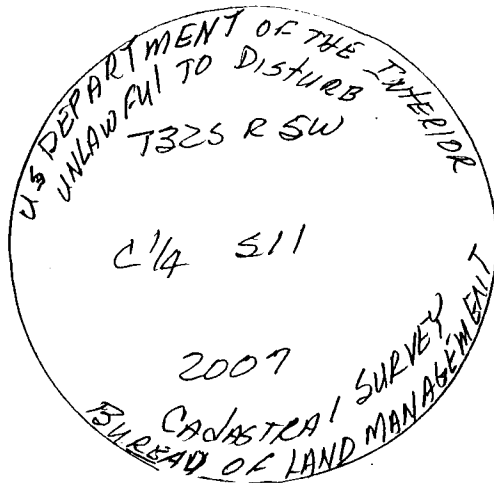

Sketch

Monument Set (Procedures and Description)

New Accessories

16" CEDAR N8°W 339 FT scribed C 1/4 S11 BT
18" FIR S88°E 49³ FT scribed C 1/4 S11 BT

Surveyor's Seal


Location & Comments

Compass Declination 15 1/2 °E
Firm/Agency: i.e. Engineering, Inc.
Address: 809 SE Pine St., Roseburg, OR 97470

Party Chief: R. VINCENT

Notes:

Witness: R. Heichel

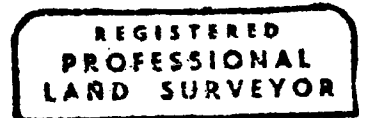

EXP 12-31-18

C.S. File 65/101-55