

FILED

Date: 4-9-2019 By: JC

This survey consists of:

Map: _____

Narrative: _____
Corner Rpt: CS 65/102-9

DOUGLAS COUNTY
SURVEYOR

CORNER REPORT FORM

Section 1 Township 32 S Range 9 W
Douglas County Date 1/04/2019
PLSS Number 700640

CORNER DESIGNATION

East 1/4 corner of
Section 1 only.

- Condition Report only
- Not Found
- Renewed
- Unrecorded
- Surveyed In
- Referenced out

Previous Renewals/Surveys, etc:

Original 1918 G.L.O. survey. 1967 Renewal by Douglas County Surveyor's Office.

Monument(s) & Accessories Found: (Condition and Source)

Found the 1917 G.L.O. brass capped iron pipe with the top 12" of same broken off and lying on the ground.

A 50" diam. Fir with healed blaze bears S 64° W, 23.5' (1967 B.T.)

A 38" diam. Fir snag with healed blaze bears N 82 1/2° W, 47.5' (1967 BT)

Original Cedar BT is a windfall.

Monument Detail

Sketch

Monument Set (Procedures and Description)

Remove broken iron pipe and set a 5/8" x 30" steel rebar with a 2 1/2" diam. aluminum cap Marked "T32S R9W 1/4 S1" and "LS 2339" and "Roseburg Resources Co."

New Accessories

A 12" diam. Cedar scribed "1/4 S1 BT" bears N 43° W., 22.0'

A six foot steel post is set 2 feet North.

Surveyor's Seal

Location & Comments

Compass Declination 15° East

Firm/Agency: David Edwards Land Surveying



Address: P.O. Box 361

Oaklnad, OR. 97462

Party Chief: Brant Miller

Notes: _____

Witness: Eric Sprinkle

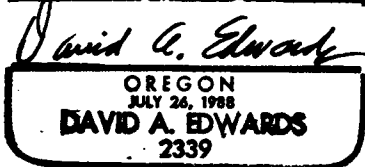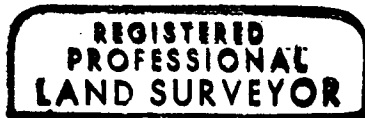

Renews 12/31/19

C.S. File 65/102-9