

FILED  
 Date: 4/9/2019 By: JC  
 This survey consists of:  
 Map: \_\_\_\_\_  
 Narrative: \_\_\_\_\_  
 Corner Rpt: CS 65/102-15

CORNER REPORT FORM

Section 2 Township 25S Range 3W  
 Douglas County Date 4-2019  
 PLSS Number  
500600

DOUGLAS COUNTY  
 SURVEYOR

CORNER DESIGNATION

Sec. 002 3/2  
10/11

- Condition Report only
- Not Found
- Renewed
- Unrecorded
- Surveyed In
- Referenced out

Previous Renewals/Surveys, etc:


GLD RESURVEY 1908 V10 Pg 3974 DCSO 1966 CS 49/88  
 DCSO 1967 DCSO 1974 CS 57/8 BLM RESURVEY AUG 1977 - April 1979  
 Monument(s) & Accessories Found: (Condition and Source) Vol 42 Pg 16443-4  
 SHANER 2000 CS 65/33-18

BLM BRASS CAP

20" FIR N71°E 79' FT	GOOD SCAR
32" FIR S27°E 32' FT	" "
17" FIR S46°W 49' FT	" "
28" FIR N152°W 73' FT	" "

Monument Detail

Sketch

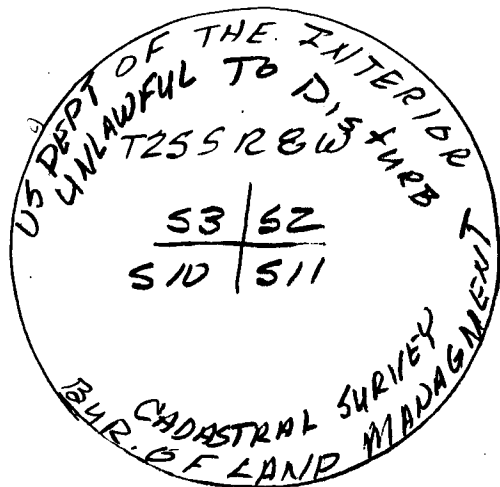

Monument Set (Procedures and Description)



New Accessories

Location & Comments

Compass Declination 15 1/2° E  
 Firm/Agency: i.e. Engineering, Inc.  
 Address: 809 SE Pine St., Roseburg, OR 97470

Party Chief: N. Fromdahl  
 Notes:  
 Witness: R. VINCENT

Surveyor's Seal

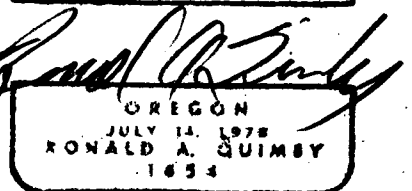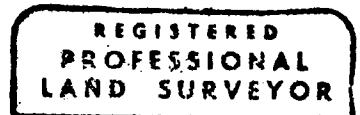

EXP 12-31-20

C.S. File 65/102-15