

FILED

Date: 4-9-2019 By: SC

This survey consists of:

Map: \_\_\_\_\_

Narrative: \_\_\_\_\_

Corner Rpt: CS 65/102-17

DOUGLAS COUNTY  
SURVEYOR

CORNER REPORT FORM

Section 2 Township 25S Range 8W  
Douglas County Date 4-2019  
PLSS Number 500640

CORNER DESIGNATION

W 1/4 COR 52 ONLY


- Condition Report only
- Not Found
- Renewed
- Unrecorded
- Surveyed In
- Referenced out

Previous Renewals/Surveys, etc:

GLO RESURVEY 1908 Vol 10 Pg 3975  
BLM RESURVEY 1964-1965 Vol 33 Pg. 13781  
Monument(s) & Accessories Found: (Condition and Source)

BLM BRASS CAP  
24" FIR N45°E 22 FT GOOD SCAR  
26' CEDAR S70°E 24 FT GOOD SCAR

Monument Detail

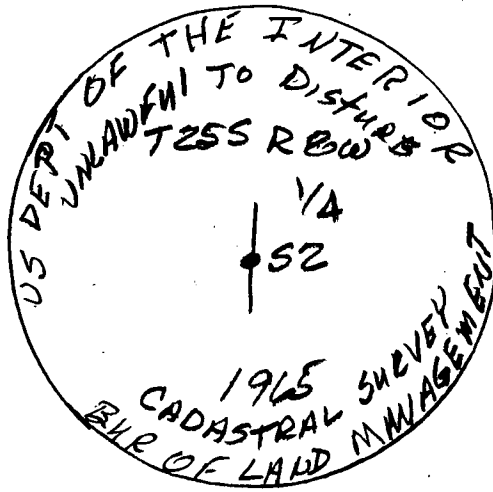

Sketch

Monument Set (Procedures and Description)

15" Hemlock N67°W 6 FT scribed 1/4 52 RT  
Alum post 1 FT south

New Accessories

Location & Comments



Compass Declination 15 1/2° E  
Firm/Agency: i.e. Engineering, Inc.  
Address: 809 SE Pine St., Roseburg, OR 97470

Party Chief: N. From Dahl

Notes:

Witness: R. VINCENT.

Surveyor's Seal

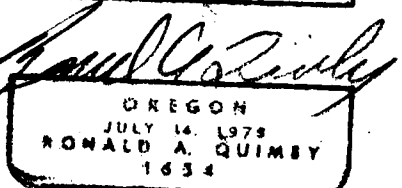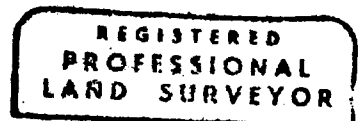

EXP 12-31-20

C.S. File 65/102-17