

FILED

Date: 4-16/2019 By: JC  
This survey consists of:

Map: \_\_\_\_\_

Narrative: \_\_\_\_\_

Corner Rpt: CS 65/102-33

DOUGLAS COUNTY  
SURVEYOR

CORNER REPORT FORM

Section 25 Township 23S Range 8W  
Douglas County Date: 4-2019  
PLSS Number

620260

CORNER DESIGNATION

N.W. 1/4 S 25

- Condition Report only
- Not Found
- Renewed
- Unrecorded
- Surveyed In
- Referenced out

Previous Renewals/Surveys, etc:

SET BY WEATHERLY 1981 CS 58/247-2A

BLM RESURVEY 1985 PG. 18-28


Monument(s) & Accessories Found: (Condition and Source)

BRASS CAP

- 18" FIR STUMP N10°W 18 FT Vis Scribe
- 40" FIR STUMP N49°E 24 FT " "
- 18" FIR SNAG N73°W 40 FT N.W. 1/4 S 25 BT

Monument Detail

Sketch

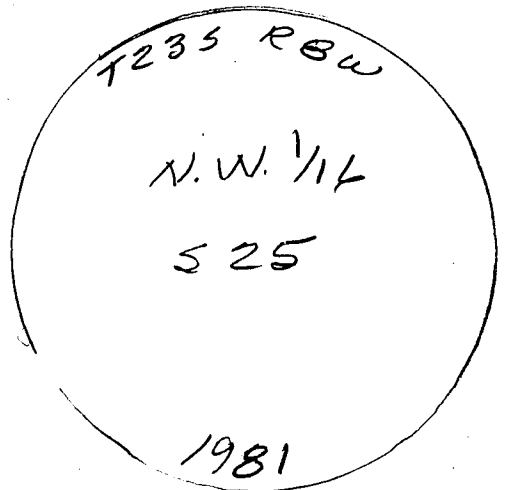

Monument Set (Procedures and Description)



New Accessories

- 11" D. FIR N86°W 39 FT SCRIBED N.W. 1/4 S 25 BT
- 16" D. FIR S39°E 6 FT SCRIBED N.W. 1/4 S 25 BT

Surveyor's Seal

Location & Comments

Compass Declination 15 1/2° E  
 Firm/Agency: i.e. Engineering, Inc.  
 Address: 809 SE Pine St., Roseburg, OR 97470  
 Party Chief: R. VINCENT  
 Notes:  
 Witness: J. OGDEN

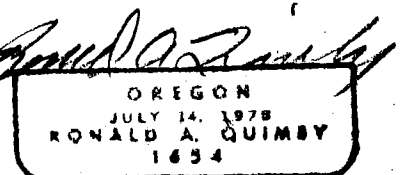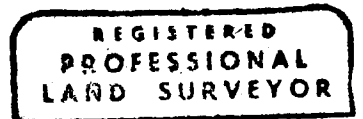

EXP 12-31-20

C.S. File 65/102-33