

FILED

Date: 4-16-2019 By: JC

This survey consists of:

Map: \_\_\_\_\_

Narrative: \_\_\_\_\_

Corner Rpt: CS 65/102-34

DOUGLAS COUNTY  
SURVEYOR

CORNER REPORT FORM

Section 25 Township 23S Range 8W  
Douglas County Date 4-2019  
PLSS Number 600260

CORNER DESIGNATION

N 1/4 S26/S25

- Condition Report only
- Not Found
- Renewed
- Unrecorded
- Surveyed In
- Referenced out

Previous Renewals/Surveys, etc:

BLM 1964 PG. 13538 Wetherly 1980 CS 58/247-2A  
BLM 1985 PG. 18289


Monument(s) & Accessories Found: (Condition and Source)

BLM BRASS CAP

16" CEDAR STUMP S37°E 22<sup>8</sup> FT  
40" D. FIR STUMP N34°W 19<sup>0</sup> FT

Monument Detail

Sketch

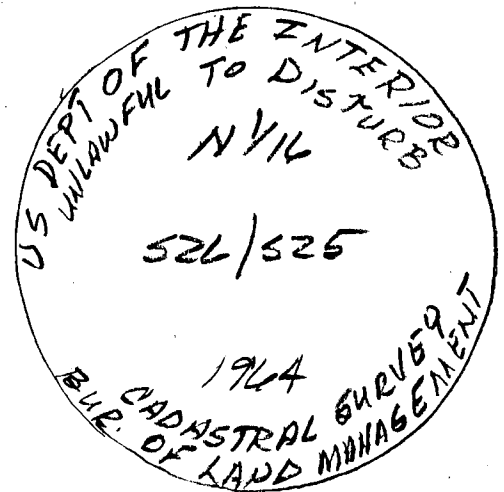

Monument Set (Procedures and Description)


New Accessories

17" D. FIR S79°E 8<sup>4</sup> FT SCRIBED N 1/4 S25 BT  
15" D. FIR N79°W 11<sup>3</sup> FT SCRIBED N 1/4 S26 BT

Surveyor's Seal

Location & Comments


Compass Declination 15 1/2° E  
Firm/Agency: i.e. Engineering, Inc.  
Address: 809 SE Pine St., Roseburg, OR 97470

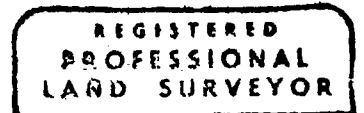

Party Chief: R. VINCENT T. [Signature]

Notes:

Witness: J. OGDEN

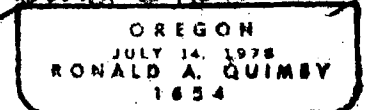

EXP 12-31-20

C.S. File 65/102-34