

FILED

Date: 4/16/2019 By: JC

This survey consists of:

Map: \_\_\_\_\_

Narrative: \_\_\_\_\_

Corner Rpt: CS 65/102-36

DOUGLAS COUNTY  
SURVEYOR

CORNER REPORT FORM

Section 25 Township 23S Range 8W

Douglas County

Date: 4-2019

PLSS Number

620300

CORNER DESIGNATION

W 1/4 S24  
S25

- Condition Report only
- Not Found
- Renewed
- Unrecorded
- Surveyed In
- Referenced out

Previous Renewals/Surveys, etc:

1980 CS 58/347-2A

BLM Resurvey 1985 PG. 1824) BLM Resurvey 1964 PG 13540

Monument(s) & Accessories Found: (Condition and Source)


BLM BRASS CAP

Rotted FIR stump S81°W 17 FT (CAPPED)

Rotted Hemlock stump N58 1/2°W 23 FT (CAPPED)

Monument Detail

Sketch

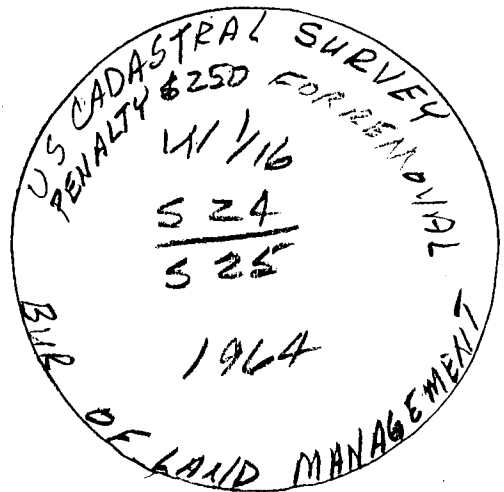

Monument Set (Procedures and Description)

New Accessories

8" D. FIR S46°E 8 FT scribed W 1/4 S25 BT

10" D. FIR N40°W 9 FT scribed W 1/4 S24 BT

Surveyor's Seal

Location & Comments

Compass Declination 15 1/2° E


Firm/Agency: i.e. Engineering, Inc.

Address: 809 SE Pine St., Roseburg, OR 97470

Party Chief: R. VINCENT

Notes:

Witness: J. OGDEN

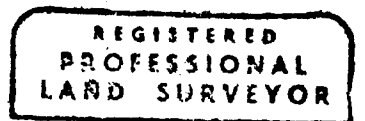

*Ronald A. Quimby*  
 OREGON  
 JULY 14, 1978  
 RONALD A. QUIMBY  
 1634

EXP 12-31-20

C.S. File 65/102-36