

CORNER REPORT FORM

Section 25 Township 23S Range 8W  
Douglas County Date 4-20-19  
PLSS Number 600220

CORNER DESIGNATION

CW 1/4 S25

Previous Renewals/Surveys, etc:

BLM RESURVEY 1985 Vol 98 18244-45

Monument(s) & Accessories Found: (Condition and Source)

BLM BRASS CAP  
20" FIR S30<sup>3</sup>14"W 27.8 FT FAINT SCAR  
27" FIR S38<sup>1</sup>2"W 29.0 FT GOOD SCAR

Monument Detail

Sketch

Monument Set (Procedures and Description)

New Accessories

22" Hemlock N63W 15.5 FT. scribed CW 1/4 S25 BT  
15" Hemlock S60E 15.7 FT scribed CW 1/4 S25 BT

Location & Comments

Compass Declination 15<sup>1</sup>/<sub>2</sub>° E  
Firm/Agency: i.e. Engineering, Inc.  
Address: 809 SE Pine St., Roseburg, OR 97470  
Party Chief: N. Fromdahl  
Notes:  
Witness: R. Heichel

FILED

Date: 5/14/2019 By: X

This survey consists of:


Map: \_\_\_\_\_

Narrative: \_\_\_\_\_

Corner Rpt: CS 65/102-39

DOUGLAS COUNTY  
SURVEYOR

- Condition Report only
- Not Found
- Renewed
- Unrecorded
- Surveyed In
- Referenced out

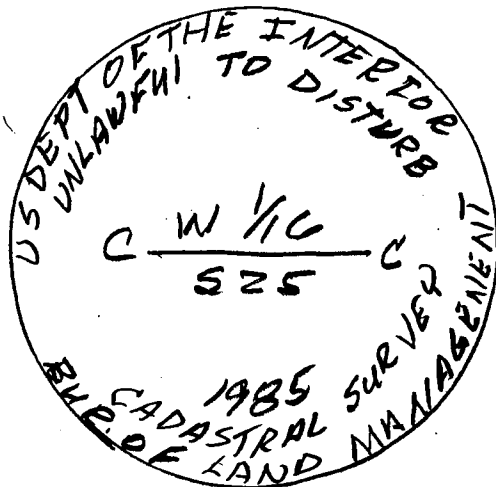

Surveyor's Seal

REGISTERED  
PROFESSIONAL  
LAND SURVEYOR

OREGON  
JULY 24, 1978  
RONALD A. QUIMBY  
1454

EX 12-31-20

C.S. File 65/102-39