

FILED

Date: 5/14/2019 By: XC

This survey consists of:

Map: _____

Narrative: _____

Corner Rpt: 05/102-45

DOUGLAS COUNTY
SURVEYOR

CORNER REPORT FORM

Section 24 Township 23S Range 8W
Douglas County Date: 4-2019
PLSS Number 640340

CORNER DESIGNATION

C 1/4 S24



Condition Report only
Not Found
Renewed
Unrecorded
Surveyed In
Referenced out

Previous Renewals/Surveys, etc:

Roberts M 86-64


Monument(s) & Accessories Found: (Condition and Source)

FD BRASS CAP

30" W. FIR N36°W 39 1/2 FT GOOD SCAR

Monument Detail

Sketch

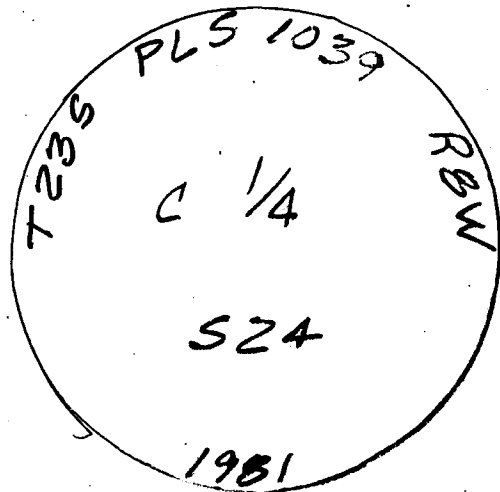

Monument Set (Procedures and Description)

New Accessories

9" FIR N58°W 6.9 FT scribed C 1/4 S24 BT
10" W. FIR S82°E 10.2 FT " " " "
13" FIR N24°E 25.4 FT " " " "
4" Hemlock NSPE 16.6 FT scribed "X"

Surveyor's Seal

Compass Declination 15 1/2° E


Firm/Agency: i.e. Engineering, Inc.

Address: 809 SE Pine St., Roseburg, OR 97470

Party Chief: N. Fromidahl

Notes:

Witness: R. Heichel

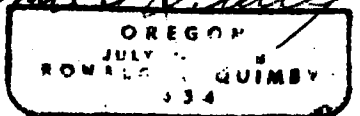

EXP 12-31-20

C.S. File 05/102-45