

FILED
Date: 5/14/2019 By: JC
This survey consists of:

CORNER REPORT FORM

Section 24 Township 23S Range 8W
Douglas County Date 4-2019
PLSS Number 700320

Map: _____
Narrative: _____
Corner Rpt: CS 65/102-47

DOUGLAS COUNTY
SURVEYOR

CORNER DESIGNATION

S 1/16 24/19

- Condition Report only
- Not Found
- Renewed
- Unrecorded
- Surveyed In
- Referenced out

Previous Renewals/Surveys, etc:

BLM Resurvey 1964 Vol 32 PG. 13531-32


Monument(s) & Accessories Found: (Condition and Source)

BLM BRASS CAP
22" maple stump S44 1/2° E 31? FT (rotted)
34" CEDAR STUMP S80 1/2° W 38? FT GOOD SCAR
1/2" REBAR 15' west

Monument Detail

Sketch

Monument Set (Procedures and Description)

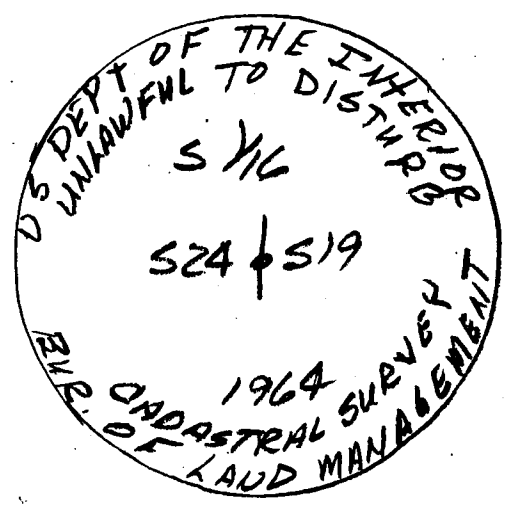

New Accessories


6' Alum post 5' west
6' Alum post 5' south

Surveyor's Seal

Location & Comments

Compass Declination 15 1/2° E
Firm/Agency: i.e. Engineering, Inc.
Address: 809 SE Pine St., Roseburg, OR 97470

Party Chief:
Notes:
Witness:

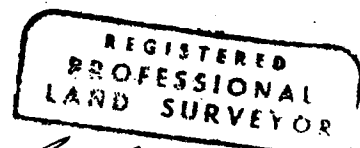

Ronald A. Quimby
OREGON
JULY 14, 1978
RONALD A. QUIMBY
1654

EXP 12-31-20
C.S. File 65/102-47