

FILED
Date: 5/14/2019 By:
This survey consists of:

CORNER REPORT FORM

Section 14 Township 24S Range 2W
Douglas County Date 5-2019
PLSS Number 540400

Map: _____
Narrative: _____
Corner Rpt: CS 65/102-48

DOUGLAS COUNTY
SURVEYOR

CORNER DESIGNATION

1/4 COR 14
23

- Condition Report only
- Not Found
- Renewed
- Unrecorded
- Surveyed In
- Referenced out

Previous Renewals/Surveys, etc:
Hosford 1957 CS 42/306

Monument(s) & Accessories Found: (Condition and Source)

1/2" I. Pipe
28" Hemlock N35°E 21' GOOD SCAR

Monument Detail

Sketch

Monument Set (Procedures and Description)


New Accessories

7" W. FIR S82°E 185' scribed 1/4 523 BT
8" Hemlock S31°E 115 FT " " " "
6" Alder West 7° FT scribed 1/4 514 BT
6" ALUM POST 2° FT EAST

Surveyor's Seal

Location & Comments


Compass Declination 15 1/2° E
Firm/Agency: I.e. Engineering, Inc.
Address: 809 SE Pine St., Roseburg, OR 97470

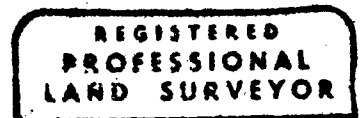

Party Chief: N. Fromdahl *Ronald A. Quimby*

Notes:

Witness: J. Ogden

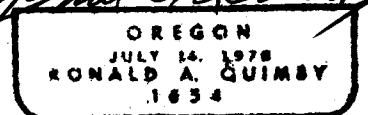

C.S. File 65/102-48