

FILED

Date: 5/16/19 By: X

This survey consists of:

Map: _____

Narrative: _____
Corner Rpt: CS 65/102-50

CORNER REPORT FORM

Section 2 Township 24S Range 8W
Douglas County Date 5-2019

PLSS Number
600640

CORNER DESIGNATION

1/4 52/51

DOUGLAS COUNTY
SURVEYOR



Condition Report only
Not Found
Renewed
Unrecorded
Surveyed In
Referenced out

Previous Renewals/Surveys, etc:

BLM Remonumention 1959 Vol 30 Pg 12613

Monument(s) & Accessories Found: (Condition and Source)

BLM BRASS CAP
28" CEDAR STUMP (Rotted) S15°E 28 FT
42" FIR STUMP S44°W 27 FT GOOD SCAR
20" FIR S26°E 32 FT GOOD SCAR
33" FIR N82 1/2°W 28 FT GOOD SCAR

Monument Detail

Sketch



Monument Set (Procedures and Description)

New Accessories

11" FIR N19°E 12 FT scribed 1/4 51 BT
13" FIR S34°W 13 FT scribed 1/4 52 BT

Surveyor's Seal



Location & Comments

Compass Declination 15 1/2° E
Firm/Agency: i.e. Engineering, Inc.
Address: 809 SE Pine St., Roseburg, OR 97470

Party Chief: N. From Dahl

Notes:

Witness: J. OGDEN

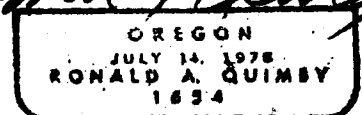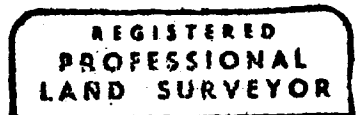

C.S. File 65/102-50
EX 12-81-20