

FILED

Date: 6/20/2019 By: SC

This survey consists of:

Map: _____

Narrative: _____
Corner Rpt: CS 65/102-53

DOUGLAS COUNTY
SURVEYOR

CORNER REPORT FORM

Section 27 Township 22S Range 8W
Douglas County Date 6-2019
PLSS Number 460240

CORNER DESIGNATION

C-E 1/16 S27

- Condition Report only
- Not Found
- Renewed
- Unrecorded
- Surveyed In
- Referenced out

Previous Renewals/Surveys, etc.:

EDWARDS 2014 M 167-12

Monument(s) & Accessories Found: (Condition and Source)

5/8" I. ROD WITH RED PLASTIC CAP DA EDWARDS LS 2339
12" FIR N120E 20.25 FT VIS SCRIBE
6' Post 24 South

Monument Detail

Sketch

Monument Set (Procedures and Description)

New Accessories

17" FIR N170W 15 FT SCRIBED CE 1/16 S27 BT

Location & Comments



Compass Declination 15 1/2° E
Firm/Agency: I.e. Engineering, Inc.
Address: 809 SE Pine St., Roseburg, OR 97470

Party Chief: N. FROMM DAHL

Notes:

Witness: J. OGDEN

Surveyor's Seal

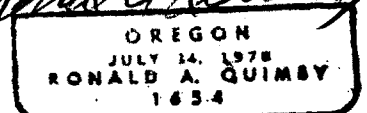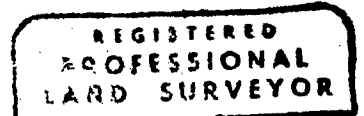

EXP 12-31-20

C.S. File 65/102-53