

CORNER REPORT FORM

Section 21 Township 32S Range 4W
Douglas County Date: 6-2019
PLSS Number
300340

CORNER DESIGNATION

1/4 COR 20121

Previous Renewals/Surveys, etc:

GERMOND 1917 FB 44 Pg 142 - wonderoth 1947 CS 38/246-1
GLB Remonumentation 1959 Vol 30 PG 12799 DeGroot 2005 M146-16
BLM Resurvey 2000 Vol 53 PG 21394-5
Monument(s) & Accessories Found: 94 Condition and Source)

BLM BRASS CAP

89" KIR SLIP 11.9 FT GOOD SCAR

34" CEDAR STUMP N15°W 33.7 FT (FACE CUT OUT)

7" D. FIR N10°W 25.2 FT FAINT SCAR

Monument Detail

Sketch

Monument Set (Procedures and Description)

New Accessories

24" D. FIR N39°E 13.0' Scribed 1/4 S21 BT
15" D. FIR N60°W 17.0' Scribed 1/4 S20 BT

Location & Comments



Compass Declination 16 1/2° E
Firm/Agency: I.e. Engineering, Inc.
Address: 809 SE Pine St., Roseburg, OR 97470

Party Chief: N. Fromdahl

Notes:

Witness: J. Ogden

Surveyor's Seal

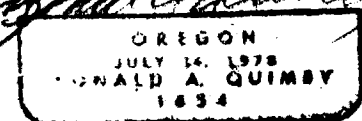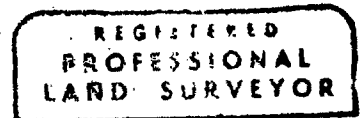

EXP 12-31-20

C.S. File 65/102-59

FILED
Date: 7/9/2019 By: J
This survey consists of:
Map:
Narrative:
Corner Rpt: CS 65/102-59

DOUGLAS COUNTY
SURVEYOR

- Condition Report only
- Not Found
- Renewed
- Unrecorded
- Surveyed In
- Referenced out

