

CORNER REPORT FORM

Section 4 Township 31S Range 3W
Douglas County Date 7-2019
PLSS Number 360640

CORNER DESIGNATION

CE 1/16 54


Previous Renewals/Surveys, etc:

Johnstone 1192-44 1982

Monument(s) & Accessories Found: (Condition and Source)

ALUM CAP ON IRON ROD
12" FIR N48°E 98 FT GOOD SCAR

Monument Detail

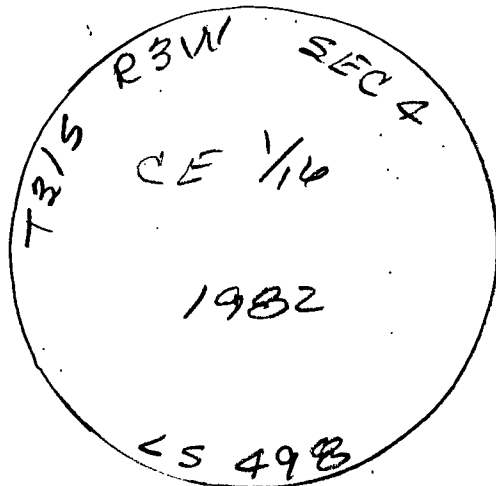

Sketch

Monument Set (Procedures and Description)

New Accessories

4" D FIR N24°W 13⁵ FT MARKED X

Location & Comments

Compass Declination 15 1/2° E

Firm/Agency: I.e. Engineering, Inc.

Address: 809 SE Pine St., Roseburg, OR 97470

Party Chief: N. From Dahl

Notes:

Witness: J. Ogden

Surveyor's Seal

REGISTERED
PROFESSIONAL
LAND SURVEYOR

Ronald A. Quimby
OREGON
JULY 14, 1978
RONALD A. QUIMBY
654

EXP 12-31-20
C.S. File 65/102-69

FILED

Date: 8-7-2019 By: X

This survey consists of:

Map: _____

Narrative: _____

Corner Rpt: CS 65/102-69

DOUGLAS COUNTY
SURVEYOR

- Condition Report only
- Not Found
- Renewed
- Unrecorded
- Surveyed In
- Referenced out