

FILED

Date: 8/20/2019 By: JC

This survey consists of:

Map: _____

Narrative: _____

Corner Rpt: CS 65/102-72

DOUGLAS COUNTY
SURVEYOR

CORNER REPORT FORM

Section 4 Township 23S Range 8W
Douglas County Date: 8/20/19
PLSS Number 300640

CORNER DESIGNATION

1/4 COR 5/4



Condition Report only
Not Found
Renewed
Unrecorded
Surveyed In
Referenced out

Previous Renewals/Surveys, etc:

DCSO 1967 CS 54/12-25A (NOT FD)
BLM RESURVEY 2009 Vol 56 PG 22267

Monument(s) & Accessories Found: (Condition and Source)

BRASS CAP ON 2 1/2" IRON PIPE (BLM)
DOWN 9" FIR S 27° E 122 FT
10" FIR N 63° W 112 FT (GOOD SCAR)

Monument Detail

Sketch

T 23S R 8W
1/4
55/54
2009

Monument Set (Procedures and Description)

18" Doug. FIR N 84° W 24.2 FT Scribed 1/4 SS BT
14" Doug. FIR S 78° E 42.7 FT Scribed 1/4 SA BT
6' POST S 62° E 5.0 FT

New Accessories

18" D. FIR N 84° W 24.2 FT Scribed 1/4 SS BT
14" D. FIR S 78° E 42.7 FT Scribed 1/4 SA BT
6' POST S 62° E 5.0 FT

Surveyor's Seal

Location & Comments

Compass Declination 15 1/2° E


Firm/Agency: I.e. Engineering, Inc.

Address: 809 SE Pine St., Roseburg, OR 97470


Party Chief: M From DMA

Notes:

Witness: J. Ogden

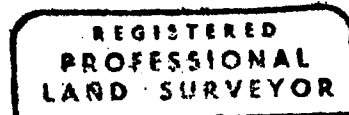

Handwritten Signature

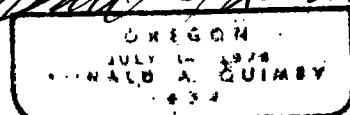

EXP 12-31-20

C.S. File 65/102-72