

FILED

Date: 9-9-2019 By: DC

This survey consists of:

Map: _____

Narrative: _____

Corner Rpt: CS 65/104-3

DOUGLAS COUNTY
SURVEYOR

CORNER REPORT FORM

Section 16 Township 31 S Range 5 W
Douglas County Date 9/6/2019
PLSS Number 340500

CORNER DESIGNATION

North 1/4 Corner

- Condition Report only
- Not Found
- Renewed
- Unrecorded
- Surveyed In
- Referenced out

Previous Renewals/Surveys, etc:

Original by W.H. Byars in 1882. Found by Templin in 1957 (C.S. 42/303)

Found and iron pipe set by King in 1959 (C.S. 42/425). Brass cap set by D.C.S. in 1966.

Monument(s) & Accessories Found: (Condition and Source)

Found 1966 D.C.S. brass capped iron pipe.

No bearing trees remain.

Monument Detail

Sketch

Standard D.C.S. brass cap.

Monument Set (Procedures and Description)

N/A



New Accessories

An 11" diam. Fir scribed "1/4 S16 BT" bears S. 48° W, 20.0 feet.

An 18" diam. Fir scribed "1/4 S9 BT" bears N. 50° E, 12.0 feet.

Surveyor's Seal

Location & Comments

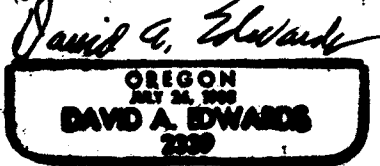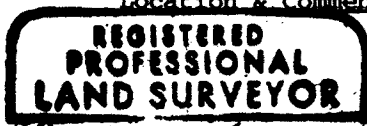

Renews 12/31/19

Compass Declination 15° East

Firm/Agency: David Edwards Land Surveying

Address: P.O. Box 361

Oakland, Oregon 97462

Party Chief: Brant Miller

Notes: _____

Witness: Eric Sprinkle

C.S. File 65/104-3