

FILED
Date: 9/11/2019 By: SC
This survey consists of:

CORNER REPORT FORM

Section 24 Township 23 S Range 7 W
Douglas County Date 9/11/2019
PLSS Number 640300

Map: _____
Narrative: _____
Corner Rpt: CS 65/104-4

DOUGLAS COUNTY
SURVEYOR

CORNER DESIGNATION

South 1/4 Corner

___ Condition Report only
___ Not Found
 Renewed
___ Unrecorded
___ Surveyed In
___ Referenced out

Previous Renewals/Surveys, etc:

Original: W.H. Byars in 1881. Survey by Shaner in 1962-M 23-62. D.C.S. visit in 1974.
Brass cap set by Shaner in 1982 on C.S. 58/229
Monument(s) & Accessories Found: (Condition and Source)

Found Shaner's 2" diam. iron pipe with 2 1/2" diam. brass cap in good condition.

Monument Detail

N/A

Sketch

Monument Set (Procedures and Description)

N/A


New Accessories

A 12" diam. Fir scribed "1/4 S24 BT" bears N. 12° W., 15.9'
A 16" diam. Fir scribed "1/4 S25 BT" bears S., 25° W., 15.0'

Surveyor's Seal

Location & Comments

Compass Declination 15° East
Firm/Agency: David Edwards Land Surveying
Address: P.O. Box 361
Oakland, Oregon 97462
Party Chief: Brant Miller
Notes: _____
Witness: Eric Sprinkle

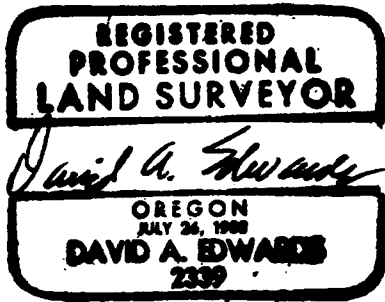

C.S. File 65/104-4