

FILED

Date: 9/23/2019 By: SC

This survey consists of:

Map: _____

Narrative: _____
Corner Rpt: CS 65/104-7

DOUGLAS COUNTY
SURVEYOR

CORNER REPORT FORM

Section 22 Township 31S Range 5W
Douglas County Date: 9/20/19
PLSS Number 500340

CORNER DESIGNATION

1/4 COR 522/523

- Condition Report only
- Not Found
- Renewed
- Unrecorded
- Surveyed In
- Referenced out

Previous Renewals/Surveys, etc:


BLM RESURVEY 1972-73 Vol 3B Pgs 15672-73

Monument(s) & Accessories Found: (Condition and Source)

BLM BRASS CAP
23" SUGAR PINE N26 1/4° E 55' FT
21" D. FIR (DEAD) N19° 00' W 32' FT

Monument Detail

Sketch

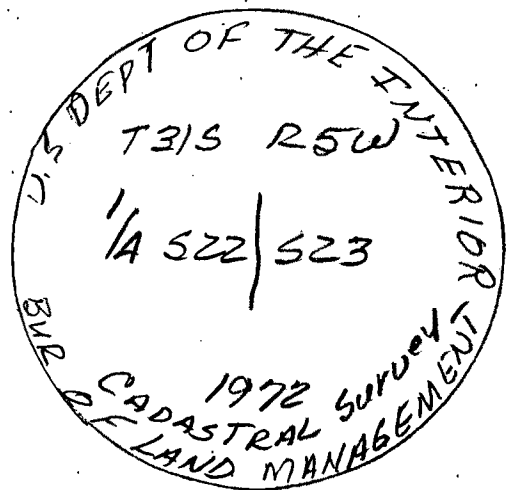

Monument Set (Procedures and Description)

New Accessories

Set 4 5/8" x 30" I. ROD with yellow plastic cap stamped
RODS set 5' FT N-S-E-W
ALUM POST set by I. ROD
ie engineering

Surveyor's Seal

Location & Comments

AREA Badly
Burnt 2019

Compass Declination 15 1/2° E


Firm/Agency: I.e. Engineering, Inc.

Address: 809 SE Pine St., Roseburg, OR 97470

Party Chief: N FROMDAH

Notes:

Witness: J. Ogden

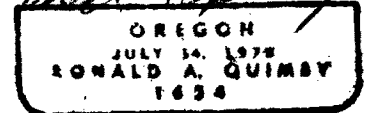

EXPIRES 7-31-20

C.S. File 65/104-7