


CORNER Vd OK

FILED
 Date: 10/22/2019 By: SC
 This survey consists of:
 Map: _____
 Narrative: _____
 Corner Rpt: CS 65/104-22
DOUGLAS COUNTY
SURVEYOR


T21S R8W
 PLS 100700
 T20S
 T21S | S31 R8W
 R9W |
 S1 | S6

Sec. COR
 PLS 200700

T20S R8W
 S31 | S32
 S6 | S5
 T21S

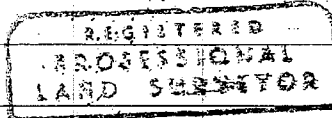

Ronald A. Gaffney

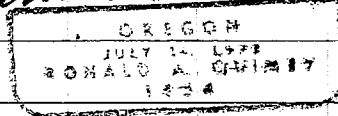

EXP 12-31-20