

FILED

Date: 10/22/2019 By: JC

This survey consists of:

Map: _____

Narrative: _____

Corner Rpt: CS 65/104-23

DOUGLAS COUNTY SURVEYOR

CORNER REPORT FORM

Section 6 Township 21S Range 8W
Douglas County Date 10-2019
PLSS Number 140700

CORNER DESIGNATION

1/4 COR S31
56

- Condition Report only
- Not Found
- Renewed
- Unrecorded
- Surveyed In
- Referenced out

Previous Renewals/Surveys, etc:


GLD Resurvey 1945 Vol 27 Pg 11389
BLM Re-monumentation 1967 Vol 43 Pg 16209

Monument(s) & Accessories Found: (Condition and Source)

GLD BRASS CAP
40" FIR STUMP S69°W 27.7 FT Vis. Scribes
50" Rotted stump S57°E 19.8 FT
17" Cedar N74°W 21.1 FT Vis Scribes
15" Cedar SNA9 S62°E 12.0 FT (TAG - No Record)

Monument Detail

Sketch

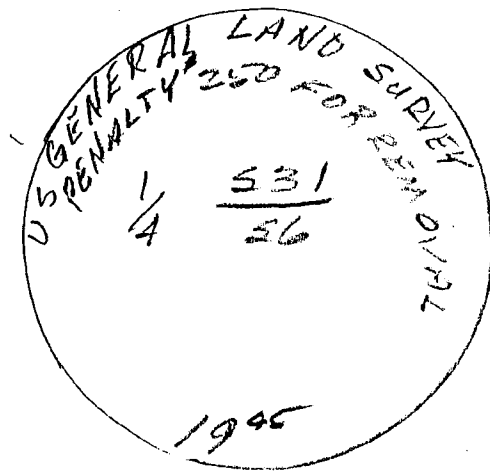

Monument Set (Procedures and Description)

New Accessories

18" D. FIR N184°E 11° FT Scribed 1/4 S31 BT
8" D. FIR S50°E 13° FT Scribed 1/4 S6 BT
10" D. FIR N46°W 8° FT Scribed 1/4 S31 BT

Location & Comments

Compass Declination 15 1/2° E
Firm/Agency: i.e. Engineering, Inc.
Address: 809 SE Pine St, Roseburg, OR 97470

Party Chief: N. Fromdah

Notes:

Witness: J. Ogden

Surveyor's Seal

REGISTERED PROFESSIONAL LAND SURVEYOR

OREGON JULY 14, 1978 RONALD A. QUIMBY 1834

EXP 12-31-20

C.S. File 65/104-23