

FILED

Date: 12/31/2019 By: JC

This survey consists of:

Map: _____

Narrative: _____

Corner Rpt: CS 65/104-29

DOUGLAS COUNTY
SURVEYOR

CORNER REPORT FORM

Section 14 Township 23 S Range 8 W
Douglas County Date Dec. 2019
PLSS Number 500500

CORNER DESIGNATION

NW corner Section 14

- Condition Report only
- Not Found
- Renewed
- Unrecorded
- Surveyed In
- Referenced out

Previous Renewals/Surveys, etc:

Original G.L.O. in 1893. D.C.S.O. renewal in 1967. B.L.M. resurvey in 1967.

Monument(s) & Accessories Found: (Condition and Source)

1967 D.C.S.O. brass capped iron pipe in good condition.
A 51" diam. original Fir B.T. with healed blaze bears N. 5° E., 29.7'
The D.C.S.O. Chinquapin S. 16° E. 11.2' is down.

Monument Detail

Sketch

Standard D.C.S.O. brass capped iron pipe.

Monument Set (Procedures and Description)

N/A


New Accessories

An 11" diam. Fir scribed "T23S R8W S14 BT" bears S. 19° E., 30.85'
A six foot steel post is set 1 foot North.

Surveyor's Seal

Location & Comments

Compass Declination 15° East
Firm/Agency: David Edwards Land Surveying
Address: P.O. Box 361
Oakland, Oregon 97462
Party Chief: Brant Miller
Notes: _____
Witness: Eric Sprinkle

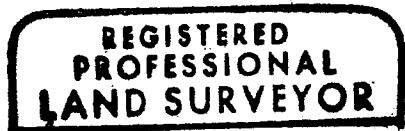

David A. Edwards
OREGON
JULY 26, 1988
DAVID A. EDWARDS
2339

Renews 12/31/19

C.S. File 65/104-29