

FILED

Date: 1-13-2020 By: Y

This survey consists of:

Map: _____

Narrative: _____

Corner Rpt: CS 65/104-30

DOUGLAS COUNTY
SURVEYOR

CORNER REPORT FORM

Section 26 Township 21 S Range 8 W
Douglas County Date 1/13/2020
PLSS Number 500240

CORNER DESIGNATION

West 1/4 Corner

- Condition Report only
- Not Found
- Renewed
- Unrecorded
- Surveyed In
- Referenced out

Previous Renewals/Surveys, etc:

Original G.L.O. in 1883. B.L.M. resurvey in 1954.
B.L.M. resurvey in 2007.

Monument(s) & Accessories Found: (Condition and Source)

Found the 1952 B.L.M. brass capped iron pipe.

A 55" diam. Fir with healed blaze bears S. 30 1/2° W., 9.9 feet. (1954 B.T.)
The 6" diam. Fir from 2007 bears S. 8 1/4° E., 22.1 feet. It is root sprung and leaning badly.
The Fir snag S. 2 1/2° E., is down.

Monument Detail

Sketch

Standard B.L.M. brass capped iron pipe.

Monument Set (Procedures and Description)

N/A

New Accessories

A 7" diam. Hemlock scribed "1/4 S26 BT" bears N. 62° E., 6.05 feet.
A 6 foot steel post is set 2 feet South.

Surveyor's Seal

Location & Comments

Compass Declination 15° East

Firm/Agency: David Edwards Land Surveying


Address: P.O. Box 361

Oakland, Oregon 97462

Party Chief: Brant Miller

Notes: _____

Witness: Eric Sprinkle

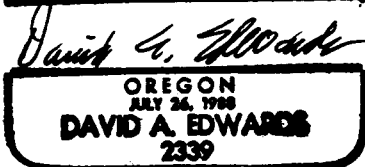

Renews 12/31/21

C.S. File 65/104-30