

FILED

Date: 2/11/2020 By: JC

This survey consists of:

Map: _____

Narrative: _____
Corner Rpt: CS 65/104-32

CORNER REPORT FORM

Section 16 Township 215 Range 9W

Douglas County

Date 1-2020

PLSS Number

400440

DOUGLAS COUNTY
SURVEYOR

CORNER DESIGNATION

1/4 COR 16/15



Condition Report only
Not Found
Renewed
Unrecorded
Surveyed In
Referenced out

Previous Renewals/Surveys, etc:

BLM RESURVEY 1963 Vol 32 Pg. 13136

Monument(s) & Accessories Found: (Condition and Source)

BLM BRASS CAP

50" FIR STUMP N 76 1/2° E 40 3/4 FT (with TAG)
48" FIR STUMP N 82° E 56! Rotted (Rec N 5 1/2° E)
Cedar stub N 31 W 54 3/4 FT Rotted

Monument Detail

Sketch

U.S. CADASTRAL SURVEY
PENALTY \$250 FOR REMOVAL

T215 R9W

1/4

S16/S15

1963

BUREAU OF LAND MANAGEMENT

Monument Set (Procedures and Description)

New Accessories

16" Hemlock N 18° W 26 3/4 FT scribed 1/4 S 1/4 BT
20" W. fir S 88° E 43 3/4 FT scribed 1/4 S 15 BT
Alum post 5° N & 5° S

Surveyor's Seal

Location & Comments

Compass Declination 15 1/2° E

Firm/Agency: i.e. Engineering, Inc.


Address:

809 SE Pine St., Roseburg, OR 97470

Party Chief: M. Fromdahl

Notes:

Witness:

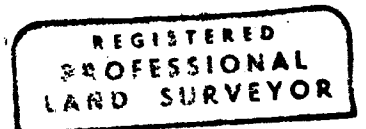

EXP 12-31-20

C.S. File 65/104-32