

FILED

Date: 2/11/2020 By: SC
This survey consists of:

Map: _____

Narrative: _____
Corner Rpt: CS 65/104-34

DOUGLAS COUNTY
SURVEYOR

CORNER REPORT FORM

Section 16 Township 21S Range 9W
Douglas County Date 12-2019
PLSS Number 300400

CORNER DESIGNATION

SEC COR 17/16
20/21

<input checked="" type="checkbox"/>
<input type="checkbox"/>
<input type="checkbox"/>
Condition Report only
Not Found
Renewed
Unrecorded
Surveyed In
Referenced out

Previous Renewals/Surveys, etc:

DCSD 1964 CS 52/14-135
BLM Resurvey 1996-97 Vol 34 Pg 14252

Monument(s) & Accessories Found: (Condition and Source)

DCSD BRASS CAP

40" FIR STUMP N19E 17^B FT GOOD SCAR
40" FIR STUMP N140W 59 FT METAL CAP GOOD SCAR
27" FIR STUMP S49E 60^B FT " " " "
47" ROTTEN FIR STUMP S69W 51^B FT (REG 559W)
18" ROTTEN HEMLOCK STUMP S58 1/2 W 45.9^B FT FACE ROTTED
49.5

UNRECORDED BEARING TREES

Monument Detail

Sketch

8" FIR N74E 11^B FT scribed T215 R9W S16 BT
7" Hemlock S8E 22^B FT scribed T215 R9W S21 BT
8" FIR S84W 11^B FT scribed T215 R9W S20 BT
13" FIR N12W 22^B FT scribed T215 R9W S17 BT

County Surveyors Office

T215

517 | 516 R
520 | 521 9
W

BLM 1966

1964

Monument Set (Procedures and Description)



New Accessories

Surveyor's Seal

Location & Comments

Compass Declination 15 1/2 E
Firm/Agency: i.e. Engineering, Inc.
Address: 809 SE Pine St., Roseburg, OR 97470

Party Chief: N. Fromdahl
Notes:
Witness: L. Heddens

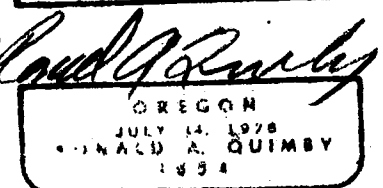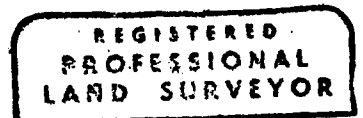

EXP 12-31-20

C.S. File 65/104-34