

FILED

Date: 3-18-2020 By: JC

This survey consists of:

Map: _____

Narrative: _____

Corner Rpt: CS 65/104-40

CORNER REPORT FORM

Section 21 Township 31S Range SW

Douglas County Date 1-2020

PLSS Number
400340

DOUGLAS COUNTY
SURVEYOR

CORNER DESIGNATION

1/4 S21/S22

- Condition Report only
- Not Found
- Renewed
- Unrecorded
- Surveyed In
- Referenced out

Previous Renewals/Surveys, etc:

KING 1959 CS 51/56 DCSD 1966 CS 54/25-24
BLM RESURVEY 1982-83 1/01 45 PA 17485-86

Monument(s) & Accessories Found: (Condition and Source)

DCSD BRASS CAP
50" CEDAR N31°E 15³ FT BARK SCRIBED
23" PINE S71E 33² FT GOOD SCAR
11" FIR N59 1/4 W 36³ FT GOOD SCAR

Monument Detail

Sketch

COUNTY SURVEYORS OFFICE
T31S R5W
1/4 S21/S22
1966

Monument Set (Procedures and Description)

New Accessories

5/8" I. ROD SSW 6² FT WITH YELLOW PLASTIC CAP
STAMPED IENGINEERING

Surveyor's Seal

Location & Comments



AREA BADLY
BURNT 2019

Compass Declination 15 1/2° E
Firm/Agency: i.e. Engineering, Inc.
Address: 809 SE Pine St., Roseburg, OR 97470

Party Chief: R. Heichele

Notes:

Witness: J. OGDEN

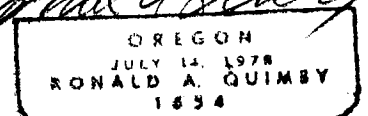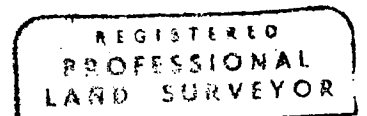

EXP 12-31-20

C.S. File 65/104-40