

FILED

Date: 3-18-2020 By: SC

This survey consists of:

Map: _____

Narrative: _____

Corner Rpt: CS 65/104-41

CORNER REPORT FORM

Section 16 Township S15 Range 5W
Douglas County Date 1-2020
PLSS Number 400400

DOUGLAS COUNTY
SURVEYOR

CORNER DESIGNATION

15/16
22/21

- Condition Report only
- Not Found
- Renewed
- Unrecorded
- Surveyed In
- Referenced out

Previous Renewals/Surveys, etc:

KING 1960 CS File 51/56 BLM Resurvey 1982-83 Vol 45
SHANER 1992 M112-49 EDWARDS 2015 CS 65/87-36 PG 17486-87

Monument(s) & Accessories Found: (Condition and Source) Quimby 2019
CS 65/104-13

BLM Alum CAP
15" FIR S38°E 43¹/₂ FT GOOD SCAR
19" FIR N67°W 28¹/₂ FT GOOD SCAR
Steel Post 2° East & 4° South

Monument Detail

Sketch

US DEPT OF INTERIOR
T21S R5W
S16/S15
S21/S22
1982

BUREAU OF LAND MANAGEMENT

Monument Set (Procedures and Description)

New Accessories

5/8" I. ROD N26°E 8¹/₂ FT Both have yellow plastic caps
5/8" I. ROD S6°E 5¹/₂ FT stamped i.e. engineering
Alum. post alongside



Surveyor's Seal

Location & Comments

AREA Badly Burnt
2019

Compass Declination 15¹/₂° E
Firm/Agency: i.e. Engineering, Inc.
Address: 809 SE Pine St., Roseburg, OR 97470

Party Chief: R. Heichel
Notes:
Witness: J. Ogden

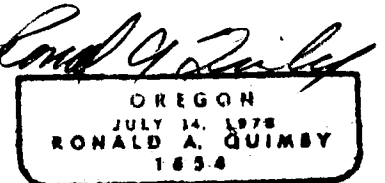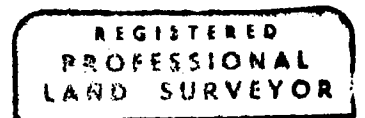

EXP 12-31-20

C.S. File 65/104-41