

FILED

Date: 3-19-2020 By: JC

This survey consists of:

Map: _____

Narrative: _____

Corner Rpt: CS 65/104-43

DOUGLAS COUNTY
SURVEYOR

CORNER REPORT FORM

Section 10 Township 31S Range 5W
Douglas County Date 1-2020
PLSS Number 400540

CORNER DESIGNATION

1/4 COR 9/10

- Condition Report only
- Not Found
- Renewed
- Unrecorded
- Surveyed In
- Referenced out

Previous Renewals/Surveys, etc:

EVANS 1955 CS 41/356 DCSO 1966 CS 54/25-26
KING 1959 CS 51/56

Monument(s) & Accessories Found: (Condition and Source)

1/8" I.P.
48" CEDAR STUMP S53°E 78° FT 1/4 Scribe

Monument Detail

Sketch

Monument Set (Procedures and Description)

New Accessories

5/8" I. ROD	S30W	52 FT
5/8" I. ROD	N74W	52 FT
5/8" I. ROD	S52E	51 FT
5/8" I. ROD	N32°E	52 FT

All rods have yellow plastic cap stamped IE engineering
5' Alum Post Alongside

Surveyor's Seal

Location & Comments

Compass Declination 15 1/2° E



Firm/Agency: i.e. Engineering, Inc.

Address: 809 SE Pine St., Roseburg, OR 97470

Party Chief: R. Heichel

Notes:

Witness: J. Ogden

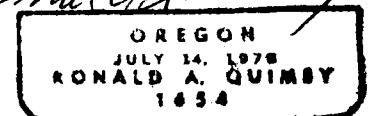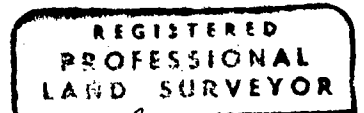

EXP 12-31-20

C.S. File 65/104-43