

FILED

Date: 3-18-2020 By: JC

This survey consists of:

Map: \_\_\_\_\_

Narrative: \_\_\_\_\_

Corner Rpt: CS 65/104-44

DOUGLAS COUNTY  
SURVEYOR

CORNER REPORT FORM

Section 10 Township 31S Range SW  
Douglas County Date 1-2020  
PLSS Number  
500 500

CORNER DESIGNATION

10/11  
15/14

- Condition Report only
- Not Found
- Renewed
- Unrecorded
- Surveyed In
- Referenced out

Previous Renewals/Surveys, etc:

BLM RESURVEY 1972-73 V3B Pg 15677

Monument(s) & Accessories Found: (Condition and Source)

BLM BRASS CAP  
20" Alder N18°E 42 FT  
27" Fir N59W 50 FT GOOD SCHR

Monument Detail

/ Sketch

U.S. DEPT. OF INTERIOR  
T31S R5W  
510/511  
515/514  
1973

Monument Set (Procedures and Description)

BUREAU OF LAND MANAGEMENT

New Accessories


5/8" I. ROD S40°E 12 FT Both have yellow plastic caps stamped IC Engineering  
5/8" I. ROD S62W 10 FT ALUM Post set  
Along side

Surveyor's Seal

Location & Comments

AREA BADLY  
BURNT 2019


Compass Declination 15 1/2° E  
Firm/Agency: i.e. Engineering, Inc.  
Address: 809 SE Pine St., Roseburg, OR 97470

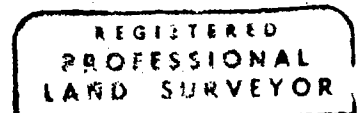

Party Chief: R. Heichel (Ronald A. Quimby)

Notes:

Witness: J. Ogden

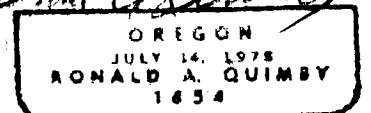

EXP 12-31-20

C.S. File 65/104-44