

FILED

Date: 3-18-2020 By: JC

This survey consists of:

Map: _____

Narrative: _____

Corner Rpt: CS 65/104-46

CORNER REPORT FORM

Section 17 Township 3/5 Range 5W
Douglas County Date 2-2020
PLSS Number 240500

DOUGLAS COUNTY
SURVEYOR

CORNER DESIGNATION

1/4 COR 8
17

- Condition Report only
- Not Found
- Renewed
- Unrecorded
- Surveyed In
- Referenced out

Previous Renewals/Surveys, etc:

BLM RESURVEY 1966-1968 Vol 55 Pg 14376-77

Monument(s) & Accessories Found: (Condition and Source)

BLM BRASS CAP
32" FIR N 38° E 224 FT
34" FIR S 85° E 264 FT

Monument Detail

Sketch

U.S. DEPT. OF THE INTERIOR
UNLAWFUL TO DISTURB
THIS RESW
1/4 SE
S17,944
CADASTRAL SURVEY
BUREAU OF LAND MANAGEMENT

Monument Set (Procedures and Description)

New Accessories

16" FIR S 28° W 415 FT SCRIBED 1/4 S 17 BT
22" FIR S 26° E 725 FT SCRIBED 1/4 S 17 BT

Surveyor's Seal

Location & Comments


AREA BURNT
2019

Compass Declination 15 1/2° E
Firm/Agency: i.e. Engineering, Inc.
Address: 809 SE Pine St., Roseburg, OR 97470

Party Chief: N. From Dahl

Notes:

Witness: L. Heddens

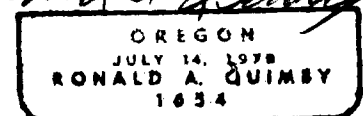

EXP 12-31-20
C.S. File 65/104-46