

FILED

Date: 3-18-2020 By: LC

This survey consists of:

Map: _____

Narrative: _____
Corner Rpt: CS 65/104-47

DOUGLAS COUNTY
SURVEYOR

CORNER REPORT FORM

Section 21 Township 31S Range 5W
Douglas County Date 2-2020
PLSS Number 300340

CORNER DESIGNATION

1/4 20/21

- Condition Report only
- Not Found
- Renewed
- Unrecorded
- Surveyed In
- Referenced out

Previous Renewals/Surveys, etc:

BLM Resurvey 1982-83 Vol 45 pg 17488-89

Monument(s) & Accessories Found: (Condition and Source)

BLM BRASS CAP
16" FIR N67°E 48 1/2 FT (BURNT)
12" FIR S48°W 36 FT (BURNT)

Monument Detail

Sketch

U.S DEPT OF INTERIOR
T31S 126W
1/4
S20 | S21
1982

Monument Set (Procedures and Description)

BUREAU OF LAND MANAGEMENT

New Accessories



PK IN ROCK N60°E 7 1/2 FT All I. Rod have yellow
5/8" x 30" I. Rod N36°W 3 1/2 FT PLASTIC CAP MARKED
5/8" x 30" I. Rod S78°W 4 1/2 FT ICE MEASURING
5/8" x 30" I. Rod S85°E 5 1/2 FT 5' ALUM POST ALONG Surveyor's Seal
Sid.

Location & Comments

AREA BOUNDARY
BURNT 2019

Compass Declination 15 1/2° E
Firm/Agency: i.e. Engineering, Inc.
Address: 809 SE Pine St., Roseburg, OR 97470

Party Chief: R. Herchel
Notes:
Witness: J. Opden

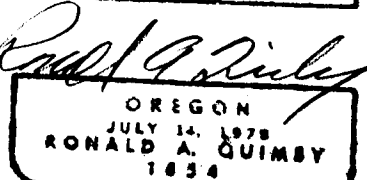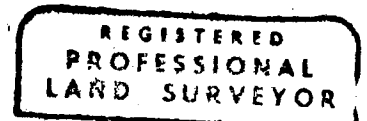

EXP 12-31-20

C.S. File 65/104-47