

FILED

Date: 3-18-2020 By: [Signature]

This survey consists of:

Map: _____

Narrative: _____

Corner Rpt: CS65/104-48

DOUGLAS COUNTY SURVEYOR

CORNER REPORT FORM

Section 21 Township 31S Range 5W
Douglas County Date 2-2020
PLSS Number 300860

CORNER DESIGNATION

N 1/4 20/21

- Condition Report only
- Not Found
- Renewed
- Unrecorded
- Surveyed In
- Referenced out

Previous Renewals/Surveys, etc:

BLM RESURVEY 1982

Monument(s) & Accessories Found: (Condition and Source)

BLM BRASS CAP

12" CEDAR N 53 3/4 E 32 3/4 FT (BURNT STUMP WITH CAP)

Monument Detail

Sketch

U.S. DEPT OF INTERIOR
N 1/4
S20/S21
1982

BUREAU OF LAND MANAGEMENT

Monument Set (Procedures and Description)

New Accessories


8" FIR N145°W 11' FT scribed N 1/4 S 20 BT
13" FIR S52W 14' FT " " " "

Surveyor's Seal

Location & Comments


AREA BADLY
BURNT 2019

Compass Declination 15 1/2° E
Firm/Agency: i.e. Engineering, Inc.
Address: 809 SE Pine St., Roseburg, OR 97470

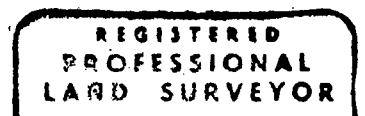

Party Chief: R. Heichel / [Signature]

Notes:
Witness: J. Ogden

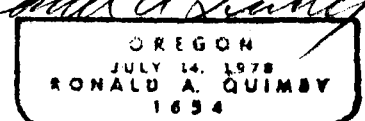

EXP 12-31-20
C.S. File 65/104-48