

FILED

Date: 3-18-2020 By: DC

This survey consists of:

Map: _____

Narrative: _____

Corner Rpt: CS 65/104-50

CORNER REPORT FORM

Section 16 Township 31S Range 5W
Douglas County Date 2-2020
PLSS Number 400440

DOUGLAS COUNTY
SURVEYOR

CORNER DESIGNATION

1/4 COR 16/15

- Condition Report only
- Not Found
- Renewed
- Unrecorded
- Surveyed In
- Referenced out

Previous Renewals/Surveys, etc:

DCSO 1996 CS 54/25-14

BLM RESURVEY 1982-83 Vol. 45 Pg 17487

Monument(s) & Accessories Found: (Condition and Source)

DCSO BRASS CAP

38" D. FIRE STUMP 1140W 4" FT

Monument Detail

Sketch

T31S R5W
1/4 516/515
1966

Monument Set (Procedures and Description)

New Accessories

5/8" I. ROD N52°E 52 FT

5/8" T. ROD S73°E 52 FT

5/8" T. ROD S6°W 52 FT

5/8" I. Rod S70°W 52 FT

All rods have yellow plastic

caps 1e engineering

5' Alum post alongside

Location & Comments

AREA badly
BURST 2019

Compass Declination 15 1/2° E

Firm/Agency: i.e. Engineering, Inc.



Address:

809 SE Pine St., Roseburg, OR 97470

Party Chief: R. Heichel

Notes:

Witness: J. Ogden

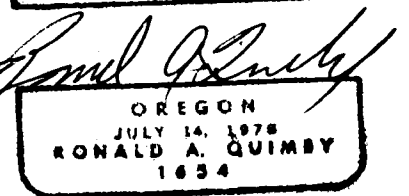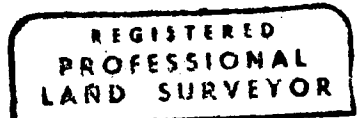

EXP 12-31-20

C.S. File 65/104-50