

FILED

Date: 3-18-2020 By: JC

This survey consists of:

Map: \_\_\_\_\_

Narrative: \_\_\_\_\_

Corner Rpt: CS65/104-51

CORNER REPORT FORM

Section 10 Township 31S Range 5W  
Douglas County Date 2-2020  
PLSS Number 400600

DOUGLAS COUNTY  
SURVEYOR

CORNER DESIGNATION

SEC COR. 4/3  
9/10

- Condition Report only
- Not Found
- Renewed
- Unrecorded
- Surveyed In
- Referenced out

Previous Renewals/Surveys, etc:

DCSD 1930 CS 16/45-CB 37/25 WINTERHAM 1957 CS 42/312  
DCSD 1966 CS 54/25-3 BLM RESURVEY 1968 Vol 35 PG 14344-47  
DCSD 2013 CS 47/38-21  
Monument(s) & Accessories Found: (Condition and Source)

BLM BRASS CAP

- 40" FIR S72°W 37<sup>±</sup> FT (HEALED SCAR CHARED)
- 36" FIR N28°W 39° FT (HEALED SCAR CHARED)
- 6" LIVE OAK N75°E 23<sup>±</sup> FT (FAINT SCRIBES CHARED)
- 7" LIVE OAK S80°E 29° FT (FAINT SCRIBES CHARED)

Monument Detail

Sketch

U.S. DEPT. OF INTERIOR  
UNLAWFUL TO DISTURB  
THIS RSW

54 | 53  
39 | 610  
1966  
CADASTRAL SURVEY  
BUR. OF LAND MANAGEMENT

Monument Set (Procedures and Description)

New Accessories

- 5/8" X 30" I. ROD S56°W 42 FT
- 5/8" X 30" I. ROD N43°W 42 FT
- 5/8" X 30" I. ROD N34°E 102 FT
- 5/8" X 30" I. ROD S52°E 51 FT



All rods have yellow  
plastic caps stamped  
1E ENGINEERING AND  
5' POST ALONG SIDE  
Surveyor's Seal

Location & Comments

AREA BURST  
BADLY 2019

Compass Declination 15 1/2° E  
Firm/Agency: i.e. Engineering, Inc.  
Address: 809 SE Pine St., Roseburg, OR 97470

Party Chief: R. Heichel  
Notes:  
Witness: J. Ogden

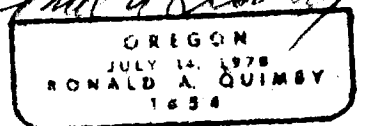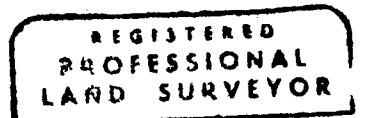

EXP 12-31-20  
C.S. File 65/104-51