

FILED

Date: 3-13-2020 By: X

This survey consists of:

Map: _____

Narrative: _____

Corner Rpt: CS 65/104-52

CORNER REPORT FORM

Section 15 Township 3/S Range 5W
Douglas County Date 2-2020
PLSS Number 440400

DOUGLAS COUNTY
SURVEYOR

CORNER DESIGNATION

1/4 COR 15/22

- Condition Report only
- Not Found
- Renewed
- Unrecorded
- Surveyed In
- Referenced out

Previous Renewals/Surveys, etc:

SHAWER 1992 M 112-49

Monument(s) & Accessories Found: (Condition and Source)

BRASS CAP
10" FIR N30E 52 FT (BURNT)

Monument Detail

Sketch

T315 R6W
1/4 515/522
RLS 430
1992

Monument Set (Procedures and Description)

New Accessories

5/8" I. ROD S31°W 82 FT
5/8" I. ROD S80W 75 FT
5/8" I. ROD N10E 42 FT
5/8" I. ROD S30E 82 FT

All rods have yellow plastic caps stamped 1ccmncr199
5' Alum post set alongside

Surveyor's Seal

Location & Comments



AREA Badly
Burnt 2019

Compass Declination 15 1/2° E
Firm/Agency: i.e. Engineering, Inc.
Address: 809 SE Pine St., Roseburg, OR 97470

Party Chief: R. Heichel

Notes:

Witness: J. Ogden

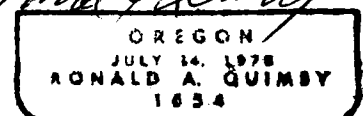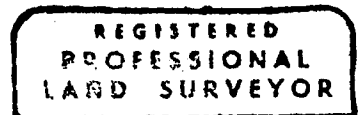

EXP 12-31-20

C.S. File 65/104-52