

FILED

Date: 3-18-2020 By: JC

This survey consists of:

Map: \_\_\_\_\_

Narrative: \_\_\_\_\_

Corner Rpt: CS 65/104-53

CORNER REPORT FORM

Section 15 Township 31S Range SW  
Douglas County Date 2-2020  
PLSS Number 500420

DOUGLAS COUNTY  
SURVEYOR

CORNER DESIGNATION

3 1/4 15/14

- Condition Report only
- Not Found
- Renewed
- Unrecorded
- Surveyed In
- Referenced out

Previous Renewals/Surveys, etc:

BLM 1973 P6 15675

Monument(s) & Accessories Found: (Condition and Source)

BLM BRASS CAP  
10" OAK S 4 1/2° W 26.9 FT

Monument Detail

Sketch

U.S. Dept of Interior  
T3)S R5W  
3 1/4  
S 15/14  
1973

Monument Set (Procedures and Description)

BUREAU OF LAND MANAGEMENT

New Accessories

5/8" I. ROD N 86° E 10.4 FT with yellow plastic CAP  
stamped 1e engineering  
5' Alum post alongside



Surveyor's Seal

Location & Comments

AREA Badly  
BURN + 2019

Compass Declination 15 1/2° E  
Firm/Agency: i.e. Engineering, Inc.  
Address: 809 SE Pine St., Roseburg, OR 97470

Party Chief: R. Heichel  
Notes:  
Witness: J. Ogden

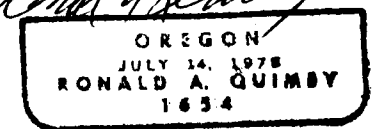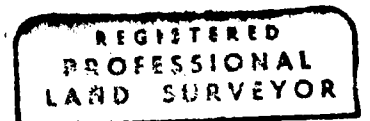

EXP 12-31-20  
C.S. File 65/104-53