

FILED

Date: 3-18-2020 By: X

This survey consists of:

Map: _____

Narrative: _____

Corner Rpt: CS 65/104-54

DOUGLAS COUNTY
SURVEYOR

CORNER REPORT FORM

Section 2 Township 31S Range 5W

Douglas County

Date 2-2020

PLSS Number 500600

CORNER DESIGNATION

SEC COR 3/2
10/11

- Condition Report only
- Not Found
- Renewed
- Unrecorded
- Surveyed In
- Referenced out

Previous Renewals/Surveys, etc:

KING April 1959 CS 42/425 DC50 MINN 1966, BLM RESURVEY
BLM RESURVEY 1972-1973 Vol 3B P9 15679-80 2017 Vol 59
Monument(s) & Accessories Found: (Condition and Source) PG 23724

BLM BRASS CAP

- 20" FIR N87°E 30° FT (BURNT)
- 20" FIR S9 1/2° E 150 FT (BURNT)
- 12" FIR S87 1/2° W 100 FT (BURNT)
- 14" FIR N43° W 90 FT (BURNT)

Monument Detail

Sketch

U.S. DEPT. OF THE INTERIOR
UNLAWFUL TO DISTURB
THIS REW

3/2
10/11

1966

CADASTRAL SURVEY
BUREAU OF LAND MANAGEMENT

Monument Set (Procedures and Description)

New Accessories

- 5/8" I. ROD N32°W 45 FT
- 5/8" I. ROD N45°E 80 FT
- 5/8" I. ROD S18°E 45 FT
- 5/8" I. ROD S56°W 50 FT

All Rod have yellow plastic
CAP'S STAMPED.
IS ENGINEERING
ALUM POST A LONG
SIDE

Surveyor's Seal

Location & Comments



AREA Bndly
BURNT 2019

Compass Declination 15 1/2° E
Firm/Agency: i.e. Engineering, Inc.
Address: 809 SE Pine St., Roseburg, OR 97470

Party Chief: R. Heichel

Notes:

Witness: J. Ogden

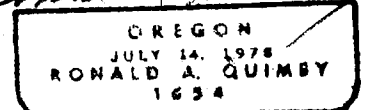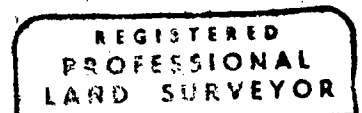

EXP 12-31-20
C.S. File 65/104-54