

FILED

Date: 3-18-2020 By: JC

This survey consists of:

Map: _____

Narrative: _____

Corner Rpt: CS 65/104-55

CORNER REPORT FORM

Section 23 Township 21S Range SW
Douglas County Date 2-2020
PLSS Number 600400

DOUGLAS COUNTY
SURVEYOR

CORNER DESIGNATION

SEC COR 14/13
23/24

- Condition Report only
- Not Found
- Renewed
- Unrecorded
- Surveyed In
- Referenced out

Previous Renewals/Surveys, etc:

BLM RESURVEY 1972-73 Vol 35 pg 15661-62

LAND 1996 M 127-73

BLM RESURVEY 1997 Vol 53 Pg 20245

Monument(s) & Accessories Found: (Condition and Source)

BLM BRASS CAP

22" OAK STUMP N50°E 32³ FT (NO MARKS)

14" FIR N120E 15² VIS SCNR

Monument Detail

Sketch

U.S. DEPT OF THE INTERIOR
T21S R5W
S14/S13
S23/S24
1973

Monument Set (Procedures and Description)

BUREAU OF LAND MANAGEMENT

New Accessories

5/8" X 30" I. ROD N81°W 5⁵ FT All rods have yellow
 5/8" X 30" I. ROD S52°E 5⁶ FT PLASTIC CAPS STAMPED
 5/8" X 30" I. ROD S.30W 4³ FT 12 ENGINEERING
 5" X 30" I. ROD S. Alum. Post
 Along side

Location & Comments



AREA BADLY
BURNT 2019

Compass Declination 15 1/2° E
Firm/Agency: i.e. Engineering, Inc.
Address: 809 SE Pine St., Roseburg, OR 97470

Party Chief: R. Heichel

Notes:

Witness: J. Onden

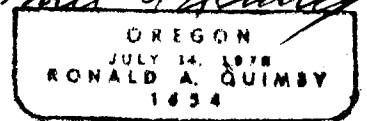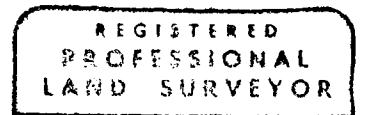

EXP 12-31-20

C.S. File 65/104-55